

PEARL RIVER

Q 35

9-26-70

MISSISSIPPI BOARD OF WATER COMMISSIONERS
416 North State Street
Jackson, Mississippi 39201

CODED

WATER WELL DRILLERS LOG

NEIL LUMPKIN WELL DRILLING SERVICE
P. O. BOX 117

Pearl River

9-26 1970
date well completed

CARRIERE, MISS.

county well located

LANDOWNER: *Thomas J. Blakely*
Picayune, Miss.
Rt. 2 - Box 146
(mailing address)

description of formations encountered	from	to
<i>Surface clay</i>	<i>0</i>	<i>20</i>
<i>sand</i>	<i>20</i>	<i>80</i>
<i>Blue clay</i>	<i>80</i>	<i>200</i>
<i>Good sand</i>	<i>200</i>	<i>258</i>

WELL LOCATION:
sec. 33 T. 4 S. R. 16 E.
4 miles East of M^cNeil
(distance) (direction) (nearest town)

WELL PURPOSE: home
(home, irrigation, municipal, industrial)

- WELL COMPLETION DATA:
- (1) diameter (inches) 2"
 - (2) total depth (feet) 258
 - (3) static water level (feet) 80 below above top of ground.
 - (4) casing galv. 252
(material) (depth)
2" if telescope see back.
(size)
 - (5) screen 5 2"
(length) (depth to top) (size) (material) St. steel
 - (6) pump 1 550 gph
(HP) (yield gph)
 - electric
(type power)
 - (7) electric log No
(yes or no)

CODED

(organization running log)

(8) how well bottom plugged Johnson
M. J. Value


NOV 3 - 1970

DRILLERS REMARKS:

MISS. BD. OF WATER COMM.

If well telescopes please sketch and show depths.

GROUND LEVEL

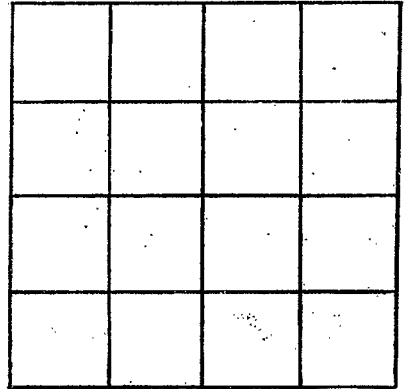

SECTION _____

Please indicate well location X.

ADDITIONAL INFORMATION

If more than one screen, show locations of each on sketch.