

**PEARL RIVER**  
**Q 36**  
**12-15-71**

MISSISSIPPI  
 BOARD OF WATER COMMISSIONERS  
 416 North State Street  
 Jackson, Mississippi 39201

WATER WELL DRILLERS LOG

**CODED**

12-15  
 date well completed

1971 Penston Well Serv  
 firm name

Pearl River  
 county well located

LANDOWNER: J.W. Atkinson  
320 Huey P. Long Ave  
Gretna La  
 (mailing address)

description of formations encountered	from	to
Surface Clay	0	35
Red sand	35	95
Blue Clay	95	168
Fine sand	168	192
Blue Clay	192	250
Sand	250	278
Blue Clay	278	420
Sand	420	498

WELL LOCATION:  
 sec. 32 T 4 S R. 16 W  
1 miles South of McNeil  
 (distance) (direction) (nearest town)

WELL PURPOSE: Home  
 (home, irrigation, municipal, industrial)

WELL COMPLETION DATA:

(1) diameter (inches) 4 X 2

(2) total depth (feet) 498

(3) static water level (feet) 26 <sup>below</sup> above top of ground.

(4) casing Galv 484  
 (material) (depth)

(size) if telescope see back.

(5) screen 15' 484  
 (length) (depth to top)

2" S. Steel  
 (size) (material)

(6) pump 3/4 12  
 (HP) (yield gpm)

Elec  
 (type power)

(7) electric log NO  
 (yes or no)

(organization running log)

**CODED**

JAN 26 1972

MISS. STATE WATER CONTROL


(8) how well bottom plugged B.W. Valve

DRILLERS REMARKS:

If well telescopes please sketch and show depths.

GROUND LEVEL

2"  
15 Ft. Screen 294 Ft. 2" Pipe 189 Ft. 4" Pipe

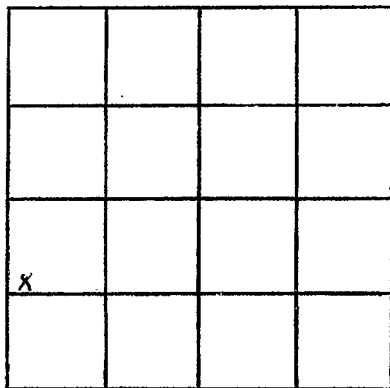

SECTION 32

Please indicate well location X.

ADDITIONAL INFORMATION

If more than one screen,  
show locations of each on sketch.