

PEARL RIVER
Q37
11-17-71

CODED
 MISSISSIPPI
 BOARD OF WATER COMMISSIONERS
 416 North State Street
 Jackson, Mississippi 39201

MAR 9 1972

WATER WELL DRILLERS LOG

11-17- 1971 Neil Lumpkin Well Pearl River
 date well completed firm name county well located
Drilling Service

LANDOWNER: Robert Morris
McNeill, Miss.

description of formations encountered	from	to
<u>Surface clay</u>	<u>0</u>	<u>20</u>
<u>Fine to better sand</u>	<u>20</u>	<u>60</u>

(mailing address)

WELL LOCATION:
 sec. 33 T 4 S R. 16 W
3 miles East of McNeill
 (distance) (direction) (nearest town)

WELL PURPOSE:
 (home, irrigation, municipal, industrial)


- WELL COMPLETION DATA:
- (1) diameter (inches) 2"
 - (2) total depth (feet) 60
 - (3) static water level (feet) _____ below/above top of ground.
 - (4) casing Plastic (material), _____ (depth),
2" (size) if telescope see back.
 - (5) screen 5' (length), _____ (depth to top),
2" (size), plastic (material)
 - (6) pump _____ (HP), _____ (yield gpm)
 _____ (type power)
 - (7) electric log no. (yes or no)
 - _____ (organization running log)
 - (8) how well bottom plugged Johnson
A P Valve

CODED

DRILLERS REMARKS:

If well telescopes please sketch and show depths.

GROUND LEVEL

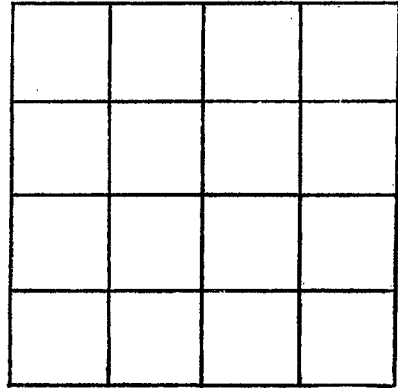

SECTION _____

Please indicate well location X.

ADDITIONAL INFORMATION

If more than one screen,
show locations of each on sketch.