

**PEARL RIVER**  
**Q 38**  
**11-6-71**

**CODED**  
 MISSISSIPPI

**BOARD OF WATER COMMISSIONERS**  
 416 North State Street  
 Jackson, Mississippi 39201

**MAR 9 1972**

**WATER WELL DRILLERS LOG**

MISS. BE. OF

11-16-1971  
 date well completed

*71 Neil Lumpkin Well Pearl River*  
 firm name  
*Drilling Service*

county well located

LANDOWNER:

*Salvadge Spiere*

description of formations encountered

from

to

*McNeill, Miss.*

*Surface clay*

0 20

(mailing address)

*Sand, good to better*

20 75

WELL LOCATION:

sec. *29 T 4 S* R. *16 W*  
 1 1/2 miles *East* of *McNeill*  
 (distance) (direction) (nearest town)

WELL PURPOSE:

*home*  
 (home, irrigation, municipal, industrial)

WELL COMPLETION DATA:

- (1) diameter (inches) *2"*
- (2) total depth (feet) *75*
- (3) static water level (feet) *20* below above top of ground.
- (4) casing *plastic* (material), (depth)  
*2"* if telescope see back.  
 (size)
- (5) screen *5'* (length), (depth to top)  
*2"*, *plastic* (size), (material)
- (6) pump *rod down* (HP), (yield gpm)  
 (type power)
- (7) electric log *no* (yes or no)

(organization running log)

(8) how well bottom plugged


*Johnson*  
*P.V.*

DRILLERS REMARKS:

**CODED**

If well telescopes please sketch and show depths.

GROUND LEVEL

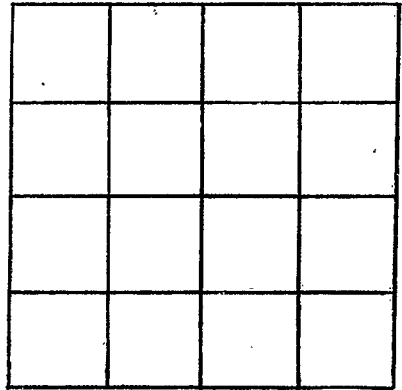

SECTION \_\_\_\_\_

Please indicate well location X.

ADDITIONAL INFORMATION

If more than one screen,  
show locations of each on sketch.