

PEARL RIVER
Q 39
11-19-71

MISSISSIPPI
 BOARD OF WATER COMMISSIONERS
 416 North State Street
 Jackson, Mississippi 39201

CODED

NOV 9 1971

WATER WELL DRILLERS LOG

MISS. BD. OF
 WATER COMI

11-19-1971 *Neil Lumphin Well Pearl River*
 date well completed firm name county well located

Drilling Service

LANDOWNER: *Holly P. Smith*

description of formations encountered

from to

Joplarville, Miss.

surface clay 0 10

Route

(mailing address)

11 sand 10 35

WELL LOCATION:

sec. *12* T. *4* S. R. *16* W.

Blue clay 35 85

3 miles *East* of *Millard*
 (distance) (direction) (nearest town)

Fine to rocks 85 153

WELL PURPOSE: *home (standard)*
 (home, irrigation, municipal, industrial)

WELL COMPLETION DATA:

- (1) diameter (inches) *2"*
- (2) total depth (feet) *15.3'*
- (3) static water level (feet) _____ below above top of ground.

CODED

- (4) casing *galv.* _____ (material) _____ (depth)
24 (size) If telescope see back.

- (5) screen *5'* _____ (length) _____ (depth to top)

- (6) pump *2"* _____ (size) *S. Steel* _____ (material)
1/2 Rod *280* gphr. (HP) (yield gpm)

electric
 (type power)

- (7) electric log *no.* _____ (yes or no)


(organization running log)

- (8) how well bottom plugged *Johnson*
B P Valve

DRILLERS REMARKS:

If well telescopes please sketch and show depths.

GROUND LEVEL

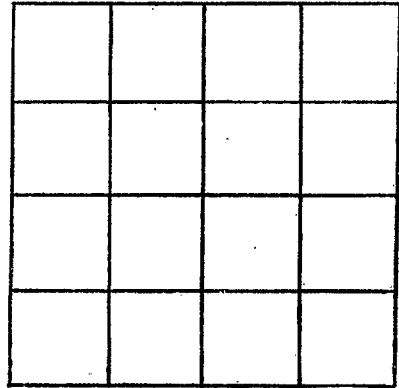

| | | | |
|--|--|--|--|
| | | | |
| | | | |
| | | | |
| | | | |

SECTION _____

Please indicate well location X.

ADDITIONAL INFORMATION

If more than one screen, show locations of each on sketch.