

**PEARL RIVER**  
**Q 40**  
**3-21-72**

MISSISSIPPI  
 BOARD OF WATER COMMISSIONERS  
 416 North State Street  
 Jackson, Mississippi 39201

**CODED**

**WATER WELL DRILLERS LOG**

3-21 1972 Penton Well Serv Pearl River  
 date well completed firm name county well located

| LANDOWNER: <u>Lizurence Wells</u>   | description of formations encountered | from       | to         |
|---|---------------------------------------|------------|------------|
| <u>M. A. Neil</u><br><u>MISS</u><br>(mailing address)   |                                       |            |            |
|   | <u>Surface Clay</u>                   | <u>0</u>   | <u>86</u>  |
|   | <u>Sand</u>                           | <u>86</u>  | <u>98</u>  |
|   | <u>White clay</u>                     | <u>98</u>  | <u>140</u> |
|   | <u>Blue clay</u>                      | <u>140</u> | <u>230</u> |
|   | <u>Sand</u>                           | <u>230</u> | <u>270</u> |
| WELL LOCATION:<br>sec. <u>8</u> T <u>4</u> S R <u>16</u> E W<br><u>2</u> miles <u>West</u> of <u>Millard</u><br>(distance) (direction) (nearest town)   |                                       |            |            |
| WELL PURPOSE: <u>Home</u><br>(home, irrigation, municipal, industrial)  |                                       |            |            |
| WELL COMPLETION DATA:<br>(1) diameter (inches) <u>2</u><br>(2) total depth (feet) <u>270</u><br>(3) static water level (feet) <u>35</u> below top of ground.<br>(4) casing <u>PVC</u> , <u>260</u> ,<br>(material) (depth)<br><u>2</u> if telescope see back.<br>(size)<br>(5) screen <u>10</u> , <u>260</u><br>(length) (depth to top)<br><u>2</u> , <u>PVC</u><br>(size) (material)<br>(6) pump <u>1</u> <u>12</u><br>(HP) (yield gpm)<br><u>Elec</u><br>(type power)<br>(7) electric log <u>NO</u><br>(yes or no)<br>(organization running log)<br>(8) how well bottom plugged <u>B.W. Valve</u> |                                       |            |            |
| DRILLERS REMARKS:   |                                       |            |            |


**CODED**

APR 11 1972

MISS. DIV. OF  
 WATER CONTROL

If well telescopes please sketch and show depths.

GROUND LEVEL

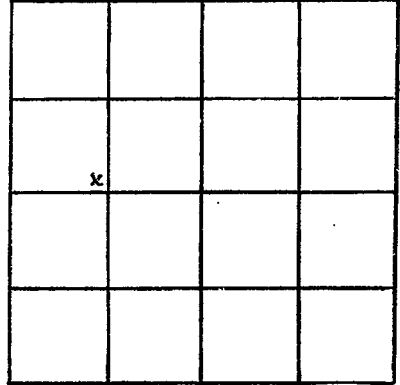

SECTION 8

Please indicate well location X.

ADDITIONAL INFORMATION

If more than one screen,  
show locations of each on sketch.