

MISSISSIPPI  
 BOARD OF WATER COMMISSIONERS  
 416 North State Street  
 Jackson, Mississippi 39201

**CODED**

WATER WELL DRILLERS LOG

PEARL RIVER  
Q 41  
6-16-72

6-16 1972 Earl Lester water well serv. Pearl River  
 date well completed firm name county well located

LANDOWNER:  
Enskallah Ranch  
Carriere, Miss.  
 (mailing address)

description of formations encountered	from	to
<u>Red clay</u>	<u>0</u>	<u>5</u>
<u>white clay</u>	<u>5</u>	<u>32</u>
<u>fine white sd.</u>	<u>32</u>	<u>38</u>
<u>Blue &amp; white clay</u>	<u>38</u>	<u>66</u>
<u>Coarse Gray sd.</u>	<u>66</u>	<u>98</u>
<u>Blue clay</u>	<u>98</u>	<u>110</u>
<u>blue coarse sd.</u>	<u>110</u>	<u>130</u>

WELL LOCATION:  
 sec 20 T 4 N R 16 E  
3 miles North of McVitt  
 (distance) (direction) (nearest town)

WELL PURPOSE: wash down  
 (home, irrigation, municipal, industrial)

- WELL COMPLETION DATA:
- (1) diameter (inches) 8
  - (2) total depth (feet) 130
  - (3) static water level (feet) 62 below above top of ground.
  - (4) casing P.V.C. 110  
 (material) (depth)  
4" If telescope see back.  
 (size)
  - (5) screen 20 110  
 (length) (depth to top)  
4" P.V.C.  
 (size) (material)
  - (6) pump 1.5hp. 900  
 (HP) (yield gpm)  
Elec.  
 (type power)
  - (7) electric log NO  
 (yes or no)
  - (organization running log)
  - (8) how well bottom plugged Shoe

**CODED**

JUL 21 1972


MISS. BO. OF  
 WATER COM.

DRILLERS REMARKS:

④

If well telescopes please sketch and show depths.

GROUND LEVEL

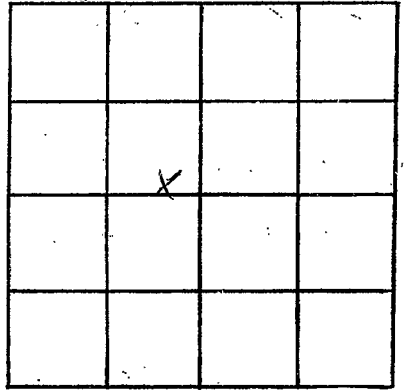

SECTION 70

Please indicate well location X.

ADDITIONAL INFORMATION

If more than one screen, show locations of each on sketch.