

PEARL RIVER
Q 42
5-6-72

MISSISSIPPI
BOARD OF WATER COMMISSIONERS
416 North State Street
Jackson, Mississippi 39201

CODED

WATER WELL DRILLERS LOG

5-6 1972 East Pearl River water well Bor. Pearl River
date well completed firm name county well located

LANDOWNER:
Mr. Roy Melvin
McNeil Miss.
(mailing address)

| description of formations encountered | from | to |
|---------------------------------------|------|-----|
| Red Clay | 0 | 14 |
| Co. white sd. | 14 | 25 |
| white clay | 25 | 38 |
| Blue clay | 38 | 166 |
| med. blue sd. | 166 | 206 |

WELL LOCATION:
sec 35 T 4 N R 16 E
2 miles East of McNeil
(distance) (direction) (nearest town)

WELL PURPOSE: Home
(home, irrigation, municipal, industrial)

WELL COMPLETION DATA:

(1) diameter (inches) 4.59
(2) total depth (feet) 206
(3) static water level (feet) 42 below top of ground
(4) casing P.C.C. 201 (material) (depth)
2" (size) if telescope see back.
(5) screen 5' 201 (length) (depth to top)
2" P.C.C. (size) (material)
(6) pump 1 (HP) 475 (yield gpm)
Elect (type power)
(7) electric log NO (yes or no)
(organization running log)
(8) how well bottom plugged shoe

CODED


MAY 21 1972

MISSISSIPPI
BOARD OF WATER COMMISSIONERS

DRILLERS REMARKS:

If well telescopes please sketch and show depths.

GROUND LEVEL

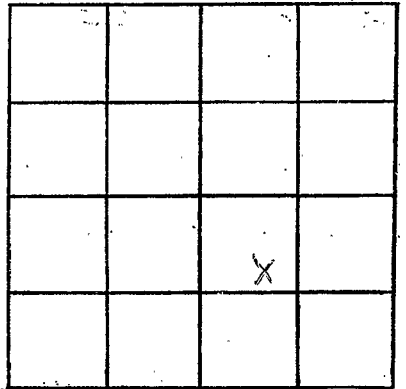

SECTION 35

Please indicate well location X.

ADDITIONAL INFORMATION

If more than one screen, show locations of each on sketch.