

PEARL RIVER
Q 43
7-14-72

MISSISSIPPI
 BOARD OF WATER COMMISSIONERS
 416 North State Street
 Jackson, Mississippi 39201
WATER WELL DRILLERS LOG

CODED

7-14-1972 **WELL LUMPKIN WELL DRILLING SERVICE** (Pearl River)
 date well completed P. O. BOX 117
 VARIETRE, MISS. county well located

LANDOWNER: <u>Barrell Hill</u>	description of formations encountered	from	to
<u>McNeill, Miss.</u> <u>39457</u> (mailing address)	<u>Surface clay</u>	0	10
WELL LOCATION: sec <u>29</u> T <u>4</u> S R <u>16</u> W <u>2</u> miles <u>East</u> of <u>McNeill</u> (distance) (direction) (nearest town)	<u>r sands</u> <u>fine to better</u>	10	58
WELL PURPOSE: <u>home</u> (home, irrigation, municipal, industrial)			
WELL COMPLETION DATA:			
(1) diameter (inches) <u>2"</u>			
(2) total depth (feet) <u>58</u>			
(3) static water level (feet) <u>30</u> below above top of ground.			
(4) casing <u>plastic</u> (material) (depth) <u>2"</u> (size) if telescope see back.			
(5) screen <u>5'</u> (length) (depth to top)			
(6) pump <u>1/2</u> <u>plastic</u> (HP) (material) <u>500 gph</u> (yield (gpm)) <u>electric</u> (this pump + tank) (type power)			
(7) electric log <u>no</u> (yes or no)			
(8) how well bottom plugged <u>Johnson</u> <u>APV</u> (organization running log)			
DRILLERS REMARKS:			


CODED

JUL 27 1972

MISS. BD. OF
 WATER COMMISSIONERS

If well telescopes please sketch and show depths.

GROUND LEVEL

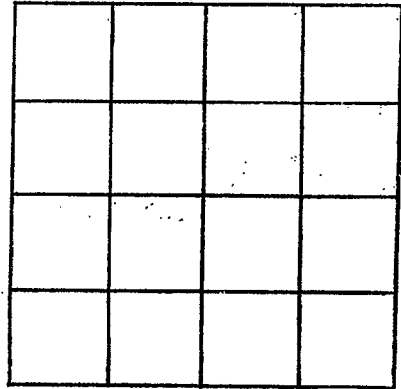

SECTION _____

Please indicate well location X.

ADDITIONAL INFORMATION

A series of horizontal lines providing space for additional information.

If more than one screen, show locations of each on sketch.