

PEARL RIVER
Q 44 CODED
7-28-72

MISSISSIPPI
 BOARD OF WATER COMMISSIONERS
 416 North State Street
 Jackson, Mississippi 39201

WATER WELL DRILLERS LOG

7-28 1972 date well completed
 72 Lanston Well Serv firm name
 Pearl River county well located

LANDOWNER: Johal Mitchell
Rt. 3
Poplarville Miss
 (mailing address)

description of formations encountered	from	to
	Surface clay	0
White clay	16	25
Blue clay	25	150
Sand	150	171

WELL LOCATION:
 sec. 8 T. 4 N. R. 16 E
 S W
2 miles West of Millard
 (distance) (direction) (nearest town)

WELL PURPOSE: Home
 (home, irrigation, municipal, industrial)


- WELL COMPLETION DATA: 4' 3"
- diameter (inches) 2
 - total depth (feet) 171
 - static water level (feet) 53 below top of ground.
 - casing PVC., 161
 (material) (depth)
2" if telescope see back.
 (size)
 - screen 10, 161
 (length) (depth to top)
2", P.V.C.
 (size) (material)
 - pump 1, 11
 (HP) (yield gpm)
Elec
 (type power)
 - electric log NO
 (yes or no)
 (organization running log)
 - how well bottom plugged Bw. Valve

DRILLERS REMARKS:

AUG 23 1972
 MISS. Bd. OF WATER COMMISSIONERS

If well telescopes please sketch and show depths.

GROUND LEVEL

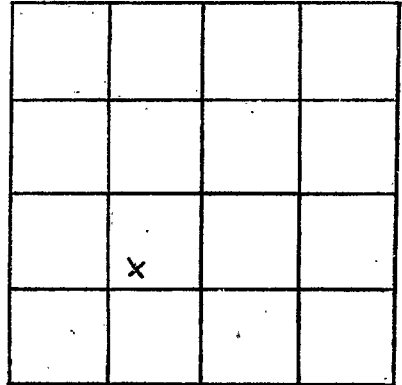

SECTION 8

Please indicate well location X.

ADDITIONAL INFORMATION

If more than one screen, show locations of each on sketch.