

PEARL RIVER
Q 45
9/12/72

MISSISSIPPI
 BOARD OF WATER COMMISSIONERS
 416 North State Street
 Jackson, Mississippi 39201

CODED

WATER WELL DRILLERS LOG

9/12 1972 Paul Henderson Pearl River
 date well completed firm name county well located

LANDOWNER: W.S. Warrington
Mr. Mel Miss
 (mailing address)

| description of formations encountered | from | to |
|---------------------------------------|------------|------------|
| <u>white shale</u> | <u>0</u> | <u>14</u> |
| <u>Rock</u> | <u>14</u> | <u>68</u> |
| <u>blue shale</u> | <u>10</u> | <u>246</u> |
| <u>blue sand</u> | <u>246</u> | <u>272</u> |

WELL LOCATION:
 sec 33 T 4 N R 16 E
2 miles E of Mr. Miss
 (distance) (direction) (nearest town)

WELL PURPOSE: home
 (home, irrigation, municipal, industrial)

WELL COMPLETION DATA:

(1) diameter (inches) 2 1/2

(2) total depth (feet) 272

(3) static water level (feet) 33 below top of ground.

(4) casing galv. 266
 (material) (depth)
 (size) if telescope see back.

(5) screen 2x5 Standard
 (length) (depth to top)
2x5 Standard
 (size) (material)

(6) pump 1/2 4308
 (HP) (yield gpm)
 (type power)

(7) electric log no
 (yes or no)
 (organization running log)

CODED


SEP 21 1972

(8) how well bottom plugged sand sharp

DRILLERS REMARKS:

If well telescopes please sketch and show depths.

GROUND LEVEL

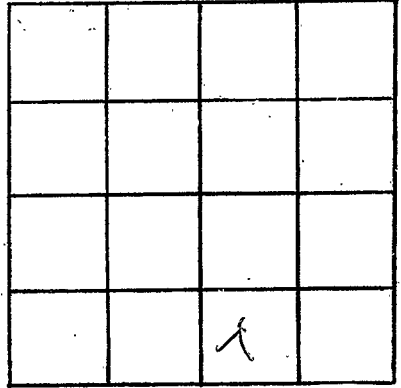

SECTION _____

Please indicate well location X.

ADDITIONAL INFORMATION

If more than one screen,
show locations of each on sketch.