

PEARL RIVER
 Q 46
 9-12-72

MISSISSIPPI
 BOARD OF WATER COMMISSIONERS
 416 North State Street
 Jackson, Mississippi 39201

CODED

WATER WELL DRILLERS LOG

9/12 1972 *Red Pointers & Sons Pearl River*
 date well completed firm name county well located

LANDOWNER:	description of formations encountered	from	to
<i>B. S. Harrington</i>	<i>Red Shell</i>	<i>0</i>	<i>34</i>
<i>Mr. Neil Miss.</i>	<i>Black Shell</i>	<i>34</i>	<i>267</i>
<i>Mr. Neil Miss. (P.O.)</i>	<i>White Sand</i>	<i>955</i>	<i>272</i>
(mailing address)			

WELL LOCATION:
 sec. 32 T. 4 N. R. 16 E.
2 1/2 miles E of *Mr. Neil*
 (distance) (direction) (nearest town)

WELL PURPOSE: *Home*
 (home, irrigation, municipal, industrial)

- WELL COMPLETION DATA:**
- (1) diameter (inches) 2 in
 - (2) total depth (feet) 272
 - (3) static water level (feet) 37 below/above top of ground.
 - (4) casing cast 267
 (material) (depth)
 (size) if telescope see back.
 - (5) screen 2 x 1/2 267
 (length) (depth to top)
2" cast
 (size) (material)
 - (6) pump 1/2 500
 (HP) (yield gpm)
Elect.
 (type power)
 - (7) electric log NO
 (yes or no)
 (organization running log)
 - (8) how well bottom plugged hard
rock


CODED

MSB 11 1072
 11 1072

DRILLERS REMARKS:

If well telescopes please sketch and show depths.

GROUND LEVEL

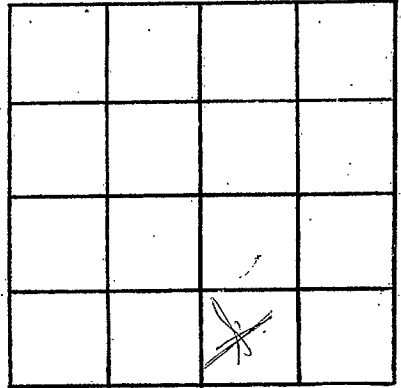

SECTION _____

Please indicate well location X.

ADDITIONAL INFORMATION

If more than one screen,
show locations of each on sketch.