

PEARL RIVER
Q 47
10-20-72

MISSISSIPPI
 BOARD OF WATER COMMISSIONERS
 416 North State Street
 Jackson, Mississippi 39201

WATER WELL DRILLERS LOG

CODED

10/20 1972 W. End of Gordon + Low Pearl River
 date well completed firm name county well located

LANDOWNER:	Description of formations encountered	from	to
<u>Holigh Speer</u>	<u>Red shal</u>	<u>0</u>	<u>36</u>
<u>R.T. 2 Box 310</u>	<u>Blue shal</u>	<u>36</u>	<u>240</u>
<u>Carriere Miss.</u> (mailing address)	<u>Blue sand</u>	<u>240</u>	<u>280</u>

WELL LOCATION:
 sec 32 T 4 N R 16 E
2 1/2 miles E of McNeil
 (distance) (direction) (nearest town)

WELL PURPOSE: home
 (home, irrigation, municipal, industrial)

CODED


- WELL COMPLETION DATA:
- (1) diameter (inches) 4 in
 - (2) total depth (feet) 280
 - (3) static water level (feet) 36 below above top of ground.
 - (4) casing PVC 270
 (material) (depth)
4"
 (size) if telescope see back.
 - (5) screen 4x10 270
 (length) (depth to top)
4" PVC
 (size) (material)
 - (6) pump 1/2 740
 (HP) (yield gpm)
Elect
 (type power)
 - (7) electric log NO
 (yes or no)
- (organization running log)
- (8) how well bottom plugged sand

DEC 11 1972

DRILLERS REMARKS:

If well telescopes please sketch and show depths.

GROUND LEVEL

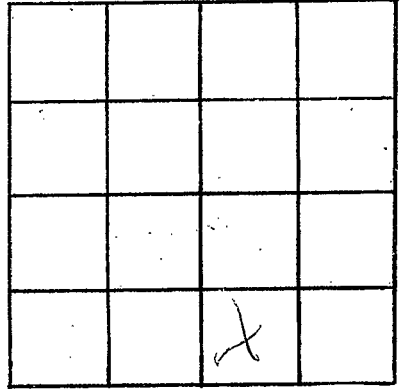

SECTION _____

Please indicate well location X.

ADDITIONAL INFORMATION

If more than one screen, show locations of each on sketch.