

PEARL RIVER
 Q 48
 11-20-72

MISSISSIPPI
 BOARD OF WATER COMMISSIONERS
 416 North State Street
 Jackson, Mississippi 39201

WATER WELL DRILLERS LOG

CODED

11-20 1972 Penitow Well Serv Pearl River
 date well completed firm name county well located

LANDOWNER: Robert Blackwell
 Nicholson Miss
 (mailing address)

description of formations encountered	from	to
Surface Clay	0	30
Red Sand	30	48
White Clay	48	75
Blue Clay	75	220
Sand	220	253

WELL LOCATION:
 sec. 19 T. 4 S. R. 16 E. W.
 1 miles North of McNeill
 (distance) (direction) (nearest town)

WELL PURPOSE: Home
 (home, irrigation, municipal, industrial)

- WELL COMPLETION DATA:
- (1) diameter (inches) 2
 - (2) total depth (feet) 253
 - (3) static water level (feet) 87 below top of ground.
 - (4) casing Galv 243
 (material) (depth)
 - 2 if telescope see back.
 (size)
 - (5) screen 10' 243
 (length) (depth to top)
 - 2 St. Steel
 (size) (material)
 - (6) pump 1 7
 (HP) (yield gpm)
 - Elec
 (type power)
 - (7) electric log No
 (yes or no)
 - (organization running log)
 - (8) how well bottom plugged Dr. Valve


CODED

DEC 10 1972
 DEC 10 1972

DRILLERS REMARKS:

If well telescopes please sketch and show depths.

GROUND LEVEL

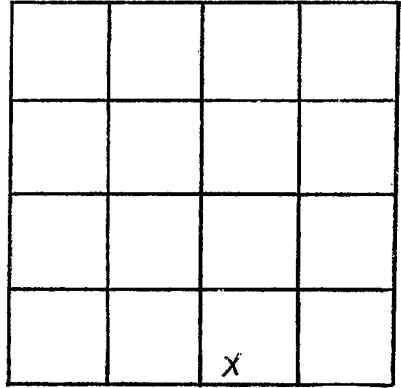

SECTION 19

Please indicate well location X.

ADDITIONAL INFORMATION

If more than one screen, show locations of each on sketch.