

PEARL River
Q 50
3-14-73

MISSISSIPPI
BOARD OF WATER COMMISSIONERS
416 North State Street
Jackson, Mississippi 39201

CODED

WATER WELL DRILLERS LOG

3-14 1973 Panton Well Serv Pearl River
date well completed firm name county well located

LANDOWNER: H.B. Spiers

description of formations encountered

from to

McNeill, Miss
(mailing address)

Surface clay	0	65
SAND	65	248
Blue clay	248	440
sand	440	540
Blue clay	540	610
sand	610	655
Blue clay	655	840
SAND	840	957

WELL LOCATION:

sec. 36 T 4 S. R. 16 W
5 miles East of McNeil
(distance) (direction) (nearest town)

WELL PURPOSE: Home
(home, irrigation, municipal, industrial)

WELL COMPLETION DATA:


- (1) diameter (inches) 2
- (2) total depth (feet) 957
- (3) static water level (feet) 8 below top of ground.
- (4) casing Galv 937
(material) (depth)
2 if telescope see back.
(size)
- (5) screen 20' 937
(length) (depth to top)
2 S. Steel
(size) (material)
- (6) pump 1/2 9
(HP) (yield gpm)
Elec
(type power)
- (7) electric log NO
(yes or no)
(organization running log)
- (8) how well bottom plugged BU. Valve

CODED

DRILLERS REMARKS:

If well telescopes please sketch and show depths.

GROUND LEVEL

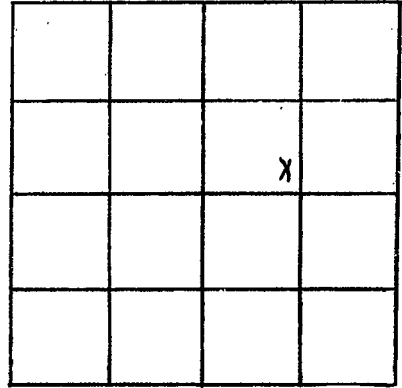

SECTION 36

Please indicate well location X.

ADDITIONAL INFORMATION

If more than one screen,
show locations of each on sketch.