

Pearl River
 Q 53
 7-14-73

MISSISSIPPI
 BOARD OF WATER COMMISSIONERS
 416 North State Street
 Jackson, Mississippi 39201

CODED

WATER WELL DRILLERS LOG

7-14 19 73 Horace A. Poole Pearl River
 date well completed firm name county well located

LANDOWNER: <u>W-Champagne</u>	description of formations encountered	from	to
<u>Rt # 1</u>	<u>Sandy Clay</u>	<u>0</u>	<u>16</u>
<u>Chickpea Miss</u> (mailing address)	<u>SAND</u>	<u>10</u>	<u>40</u>
	<u>CLAY</u>	<u>40</u>	<u>200</u>
	<u>SAND & Gravel</u>	<u>200</u>	<u>283</u>

WELL LOCATION:
 sec 12 T 4 N R 16 E
15 miles SW of Pellissippi
 (distance) (direction) (nearest town)

WELL PURPOSE: irrigation
 (home, irrigation, municipal, industrial)

- WELL COMPLETION DATA:
- (1) diameter (inches) 4 1/2
 - (2) total depth (feet) 283
 - (3) static water level (feet) 2' ^{below} above top of ground.
 - (4) casing Galv 273
 (material) (depth)
2" if telescope see back.
 (size)
 - (5) screen 10" 273
 (length) (depth to top)
2" O.10. Steel
 (size) (material)
 - (6) pump 0 0
 (HP) (yield gpm)
 (type power)
 - (7) electric log _____
 (yes or no)
 (organization running log)
 - (8) how well bottom plugged _____
Bit, Valve


CODED

DRILLERS REMARKS:
5# Pressure
2ft Above ground

AUG 3 1973

If well telescopes please sketch and show depths.

GROUND LEVEL

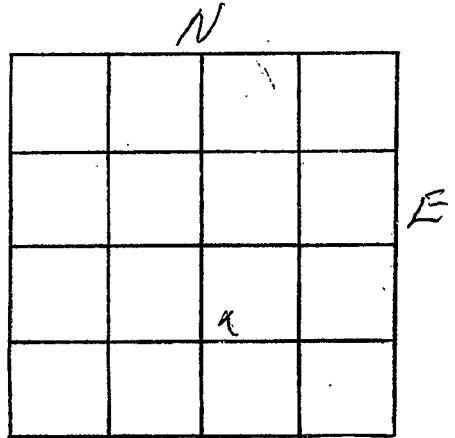

SECTION 12-4-16

Please indicate well location X.

ADDITIONAL INFORMATION

If more than one screen, show locations of each on sketch.