

P.R.
 Q.55
 1-4-74

MISSISSIPPI *Walter Penton*
 BOARD OF WATER COMMISSIONERS
 416 North State Street
 Jackson, Mississippi 39201

CODED

WATER WELL DRILLERS LOG

1-4 19*74* *Penton Well Serv* *Pearl River*
 date well completed firm name county well located

LANDOWNER: *W.C. Lee*
P.O. Box 492
Carriere Miss
 (mailing address)

description of formations encountered	from	to
<i>Surface Clay</i>	<i>0</i>	<i>95</i>
<i>Sand</i>	<i>95</i>	<i>245</i>
<i>Blue Clay</i>	<i>245</i>	<i>395</i>
<i>Sand</i>	<i>395</i>	<i>425</i>
<i>Blue Clay</i>	<i>425</i>	<i>760</i>
<i>Sand</i>	<i>760</i>	<i>800</i>

WELL LOCATION:
 sec. *25* T. *4* S. R. *16* W.
5 miles *East* of *McNeil*
 (distance) (direction) (nearest town)

CODED

WELL PURPOSE: *Home*
 (home, irrigation, municipal, industrial)

WELL COMPLETION DATA:

(1) diameter (inches) *2*

(2) total depth (feet) *800*

(3) static water level (feet) *36* below top of ground.

(4) casing *Galv*, *790*
 (material) (depth)
2 If telescope see back.
 (size)

(5) screen *10*, *790*
 (length) (depth to top)
2, *S. Steel*
 (size) (material)


(6) pump *1/2*, *7*
 (HP) (yield gpm)
Eloc
 (type power)

(7) electric log *NO*
 (yes or no)

(organization running log)


(8) how well bottom plugged *B.W. value*

DRILLERS REMARKS:

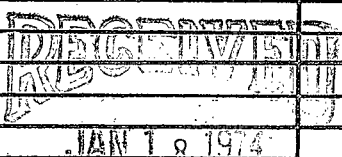

If well telescopes please sketch and show depths.

GROUND LEVEL

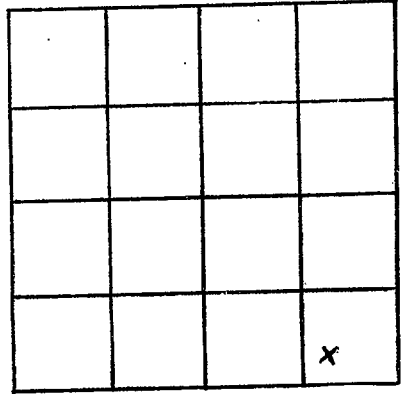

SECTION 25

Please indicate well location X.

ADDITIONAL INFORMATION

If more than one screen, show locations of each on sketch.