

P.R.
 Q56
 12-28-73

MISSISSIPPI *Walter Penton*
 BOARD OF WATER COMMISSIONERS
 416 North State Street
 Jackson, Mississippi 39201

CODED

WATER WELL DRILLERS LOG

12-28 19*73* *Penton Well Serv* *Pearl River*
 date well completed firm name county well located

LANDOWNER: *Gene Thompson*
McNeill Miss

description of formations encountered	from	to
<i>Surface Clay</i>	<i>0</i>	<i>20</i>
<i>Black Clay</i>	<i>20</i>	<i>50</i>
<i>Mud</i>	<i>50</i>	<i>75</i>
<i>Blue Clay</i>	<i>75</i>	<i>150</i>
<i>Sand</i>	<i>150</i>	<i>180</i>
<i>Blue Clay</i>	<i>180</i>	<i>260</i>
<i>Sand</i>	<i>260</i>	<i>325</i>
<i>Blue Clay</i>	<i>325</i>	<i>665</i>
<i>Sand</i>	<i>665</i>	<i>724</i>

(mailing address)
 WELL LOCATION:
 sec. *29* T *4* S R *16* E W
1 miles *East* of *McNeill*
 (distance) (direction) (nearest town)

WELL PURPOSE: *Home*
 (home, irrigation, municipal, industrial)


- WELL COMPLETION DATA:
- (1) diameter (inches) *2*
 - (2) total depth (feet) *724*
 - (3) static water level (feet) *84* *below* top of ground. *above*
 - (4) casing *Galv* *714*
 (material) (depth)
2 if telescope see back.
 (size)
 - (5) screen *10* *714*
 (length) (depth to top)
2 *steel*
 (size) (material)
 - (6) pump *1* *7*
 (HP) (yield gpm)
Elec
 (type power)
 - (7) electric log *NO*
 (yes or no)

CODED

(organization running log)

(8) how well bottom plugged *Bill Carter*


DRILLERS REMARKS:

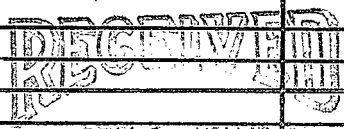

JAN 1 5 1974

If well telescopes please sketch and show depths.

GROUND LEVEL

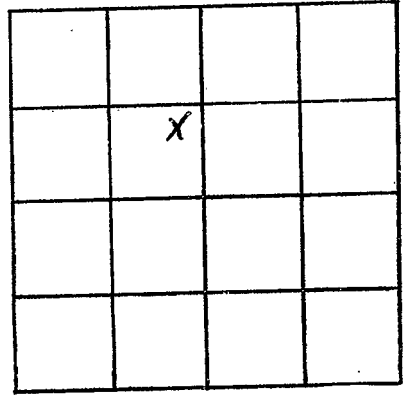

SECTION 29

Please indicate well location X.

ADDITIONAL INFORMATION

If more than one screen, show locations of each on sketch.