

Pearl River  
Q 63  
2-14-77

MISSISSIPPI  
BOARD OF WATER COMMISSIONERS  
416 North State Street  
Jackson, Mississippi 39201

CODED

13V

WATER WELL DRILLERS LOG

STOCKSTILL BROS., INC.

*Pearl River*

7-14

1977

date well completed

firm name

county well located

LANDOWNER:

Mr. Henry Campbell  
3530 Oakmeil St.  
New Orleans, La  
Benefield (mailing address)

description of formations encountered

from

to

Clay	0	20
Sand	20	130
Clay	130	195
Sand	195	266

WELL LOCATION:

sec. 25 T. 4 N. R. 16 E.  
5 miles E. of DeNeale  
(distance) (direction) (nearest town)

WELL PURPOSE:

Home

CODED

WELL COMPLETION DATA:

- (1) diameter (inches) 4"
- (2) total depth (feet) 266'
- (3) static water level (feet) 119' below top of ground.
- (4) casing P.V.C. 256' (material) (depth)  
4" (size) If telescope see back.
- (5) screen 18' 256' (length) (depth to top)  
4" P.V.C. (size) (material)
- (6) pump 1 1/2 HP 50 (yield gpm)  
Elec- (type power)
- (7) electric log No (yes or no)  
No (organization running log)
- (8) how well bottom plugged *Sand & shells*


RECEIVED  
SEP 22 1977

MISS. BD. OF WATER COMMISSIONERS

DRILLERS REMARKS:

If well telescopes please sketch and show depths.

GROUND LEVEL

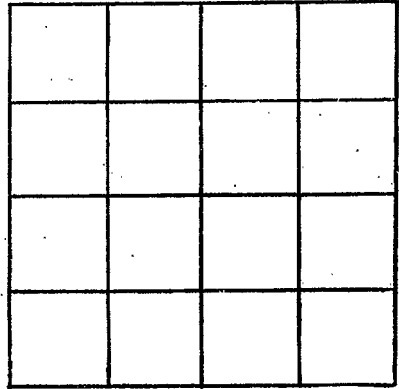

SECTION \_\_\_\_\_

Please indicate well location X.

ADDITIONAL INFORMATION

If more than one screen, show locations of each on sketch.