

MISSISSIPPI DEPARTMENT OF NATURAL RESOURCES

Bureau of Land and Water Resources

Southport Mall

CODED

P.O. Box 10631

Jackson, Mississippi 39209

WATER WELL DRILLERS LOG

Q 64  
PEARL RIVER  
2-28-85

2-28-85 date well completed  
Griner Drilling Service, Inc. firm name  
Pearl River county well located

LANDOWNER:  
Exxon Company U.S.A.  
P.O. Box 53225  
Columbia, MS. 70160  
(mailing address)

description of formations encountered	from	to
SAND - clay	0	168
SAND - PEA GRAVEL	168	315

WELL LOCATION: 1500'S & 1500'E  
sec. 4 T 4 N R 16 E of  
No. 2000 Millard of  
Box 2000 (address) (direction) (nearest town)

WELL PURPOSE: oilfield supply  
(home, irrigation, municipal, industrial)

WELL COMPLETION DATA:

(1) diameter (inches) 4"  
total depth (feet) 315

(2) static water level (feet) 90' below above top of ground.

(3) casing steel 315' (material) (depth)  
4" (size) if telescope see back.

(4) screen 42' 273' (length) (depth to top)  
4" perforated (size) (material)

(5) pump 5 70 (HP) (yield gpm)  
230 volt 3 phase (type power)

(6) electric log (yes or no)

(7) (organization running log)

(8) how well bottom plugged orange peel


DRILLERS REMARKS:

RECEIVED  
MAR 13 1985

Department of Natural Resources  
Bureau of Land & Water Resources

If well telescopes please sketch and show depths.

GROUND LEVEL

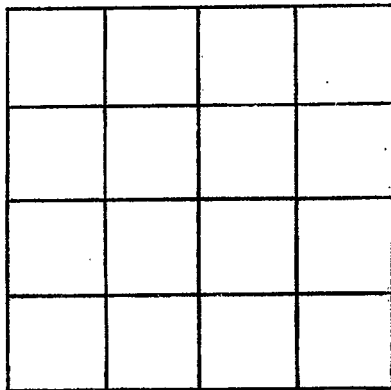

SECTION \_\_\_\_\_

Please indicate well location X.

ADDITIONAL INFORMATION

If more than one screen, show locations of each on sketch.