

MISSISSIPPI DEPARTMENT OF NATURAL RESOURCES
Bureau of Land and Water Resources
 Southport Mall
 P.O. Box 10631
 Jackson, Mississippi 39209
WATER WELL DRILLERS LOG

CODED

Q 65
PEARL RIVER
2-28-85

2-28-85 date well completed Griner Drilling Service, Inc. firm name Pearl River county well located

LANDOWNER:
EXXON CO., U.S.A.
P.O. Box 53225
New Orleans, La. 70160
 (mailing address)

description of formations encountered	from	to
<u>clay, sand</u>	<u>0</u>	<u>168</u>
<u>sand, pea gravel</u>	<u>168</u>	<u>315</u>

WELL LOCATION: 1500'S & 1500'E
 sec. 4 T 4 N R. 16 E of Millard
 No. 2 Bayson miles 3 of Millard
McGhee (distance) (direction) (nearest town)

<u>clay, sand</u>	<u>315</u>	<u>404</u>
<u>SAND</u>	<u>404</u>	<u>483</u>

WELL PURPOSE: oilfield supply
 (home, irrigation, municipal, industrial)

WELL COMPLETION DATA:


- #1 water well
- (1) diameter (inches) 4"
- (2) total depth (feet) 483'
- (3) static water level (feet) 100' below above top of ground.
- (4) casing 483' of 4" casing
 (material) (depth)
4" if telescope see back.
 (size)
- (5) screen 42' 44'
 (length) (depth to top)
4" perforated
 (size) (material)
- (6) pump — 85
 (HP) (yield gpm)
AC
 (type power)
- (7) electric log —
 (yes or no)
- (8) how well bottom plugged orange
peel

RECEIVED
MAR 13 1985

DRILLERS REMARKS:

If well telescopes please sketch and show depths.

GROUND LEVEL

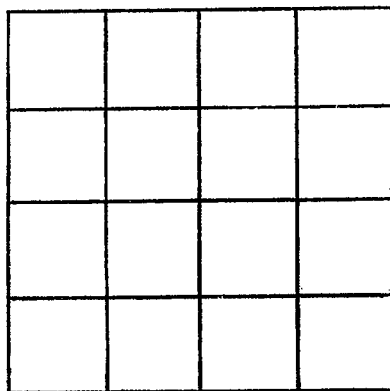

SECTION _____

Please indicate well location X.

ADDITIONAL INFORMATION

If more than one screen, show locations of each on sketch.