

Pearl River  
Q 2000

MISSISSIPPI BOARD OF WATER COMMISSIONERS

11-66

WATER WELL DRILLERS LOG

Date: 11-2, 1966, Driller: Walter Panton County Pearl River

(Name)

(1) Owner of Land: Otis Lott  
(Name)  
McNeill Miss  
(Address)

(2) Location: SW 1/4, NW 1/4, Sec. 30 T4 R16  
1 miles West of McNeill  
(distance) (direction) (Nearest Town)

(3) Topography: Hilly  
(Hilly) (Flat) (Level)

(4) Purpose of Well: Domestic  
(Domestic Irrigation  
Municipal, Industrial, Other)

Description & Color of Materials  
Sand, Clay, Red Clay, Shell, etc.

Thick-  
ness  
Feet

Depth  
Feet

Red Clay	28	0-28
" Mud	30	58
White sand	31	89

Information upon completion of well:

(1) Diameter 2 inches.

(2) Total Depth 89 feet.

(3) Water Level 44 feet below top of ground.

(4) Cased to 84, Size 2"


(5) Screen: Size 2", Length 5'

(6) Were any formations sealed against pollution?  
 yes,  no.

If YES depth of formation \_\_\_\_\_

Why \_\_\_\_\_

Drillers Remarks: \_\_\_\_\_

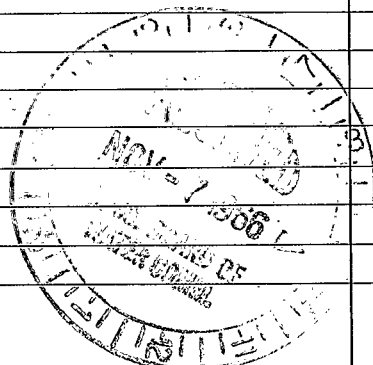

(Use Back Side)

Well No.

