

Pearl River

22001

4-67

MISSISSIPPI
 BOARD OF WATER COMMISSIONERS
 416 North State Street
 Jackson, Mississippi 39201

WATER WELL DRILLERS LOG

4-14

19 67 Ponton Well Serv

Pearl River

date well completed

firm name

county well located

LANDOWNER: Healy Hebert

Rt 1

NO Box #

description of formations encountered

from

to

Carriere Miss

(mailing address)

White Clay

0 40

Blue Clay

40 72

" Sand

72 77

Blue Clay

77 118

Grey Sand

118 135

Blue Clay

135 210

Grey Sand

210 263

WELL LOCATION:

sec 7 T 4 S R 16 W

2 miles West of Millard
(distance) (direction) (nearest town)

WELL PURPOSE: Home

(home; irrigation, municipal, industrial)

WELL COMPLETION DATA:

(1) diameter (inches) 2"

(2) total depth (feet) 263

(3) static water level (feet) 41 below top of ground.

(4) casing Galv Steel, 258
(material) (depth)

if telescope see back.
(size)

(5) screen 5', 258
(length) (depth to top)

.012 2", S. steel
(size) (material)

(6) pump 1/2 320
(HP) (yield gpm)


Elec
(type power)

(7) electric log NO
(yes or no)

(organization running log)

(8) how well bottom plugged BW Valve

DRILLERS REMARKS:

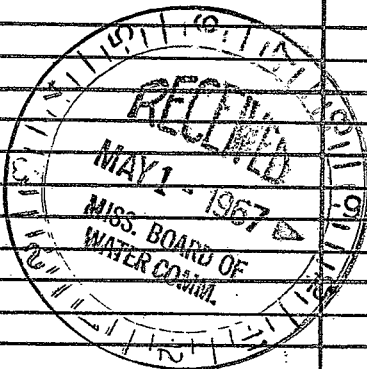

If well telescopes please sketch and show depths.

GROUND LEVEL

			X

SECTION 7

Please indicate well location X.

ADDITIONAL INFORMATION

If more than one screen, show locations of each on sketch.