

Pearl River
 Q 2002
 4-67

MISSISSIPPI
 BOARD OF WATER COMMISSIONERS
 416 North State Street
 Jackson, Mississippi 39201

WATER WELL DRILLERS LOG

April 8, 1967 Neil Lumpkin Pearl River
 date well completed firm name county well located

LANDOWNER: James Spiers
McNeill, Miss.
 (mailing address)

description of formations encountered	from to	
	feet	feet
Surface clay	0	10
" Sand	10	38


WELL LOCATION:
 sec. 34 T 4 N R 16 E
4 miles EAST of McNEILL
 (distance) (direction) (nearest town)

WELL PURPOSE: Industrial
 (home, irrigation, municipal, industrial)

Service Station

WELL COMPLETION DATA:


- (1) diameter (inches) 2"
- (2) total depth (feet) 38'
- (3) static water level (feet) RD below top of ground.
- (4) casing plastic (material) (depth)
2" if telescope see back. (size)
- (5) screen 5' (length) (depth to top)
2" (size) plastic (material)
- (6) pump 1/2 (HP) 400gal (yield gpm) per hour
electric (type power)
- (7) electric log no (yes or no)
 (organization running log)
- (8) how well bottom plugged Johnson lock pressure valve

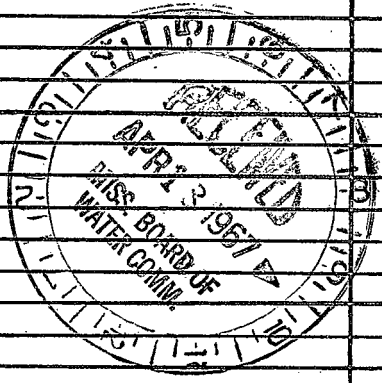

DRILLERS REMARKS:

If well telescopes please sketch and show depths.

GROUND LEVEL

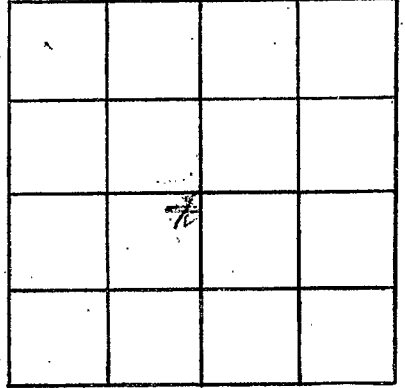

SECTION 34

Please indicate well location X.

ADDITIONAL INFORMATION

If more than one screen, show locations of each on sketch.