

Pearl River
 0 2005
 10-31-75

MISSISSIPPI
 BOARD OF WATER COMMISSIONERS
 416 North State Street
 Jackson, Mississippi 39201

WATER WELL DRILLERS LOG

10-31 1975 Pantoni Well Serv Pearl River
 date well completed firm name county well located

LANDOWNER: H.M. Harris
P. 2.
Carriere Miss
 (mailing address)

WELL LOCATION:
 sec. 35 T 4 S R. 16 E 13V W
4 miles East of McNeil
 (distance) (direction) (nearest town)

WELL PURPOSE: Home
 (home, irrigation, municipal, industrial)

WELL COMPLETION DATA:

(1) diameter (inches) 2

(2) total depth (feet) 960

(3) static water level (feet) 53 below above top of ground.

(4) casing Galv. 940
 (material) (depth)
4x2 if telescope see back.
 (size)

(5) screen 20 940
 (length) (depth to top)
2 S. Steel
 (size) (material)

(6) pump
 (HP) (yield gpm)

 (type power)

(7) electric log NO
 (yes or no)

 (organization running log)

(8) how well bottom plugged B.W. Value

description of formations encountered	from	to
Surface Clay	0	20
White Clay	20	40
Blue Clay	40	200
Sand	200	340
Blue Clay	340	490
Silt	490	580
Fine Sand	580	625
Blue Clay	625	905
Sand	905	960

DEC. - 1 1975

MISS. BD. OF WATER COMMISSIONERS


DRILLERS REMARKS:

If well telescopes please sketch and show depths.

GROUND LEVEL

126' 4"

834' 2"

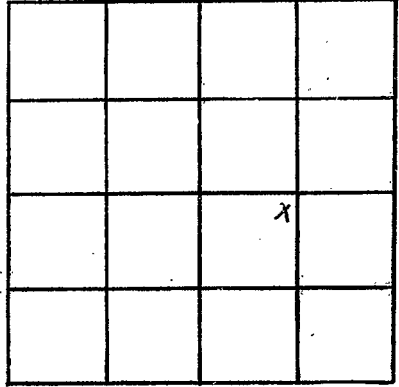

SECTION 35

Please indicate well location X.

ADDITIONAL INFORMATION

Lined area for additional information.

If more than one screen, show locations of each on sketch.