

PEARL RIVER  
 00006  
 3-7-76

MISSISSIPPI  
 BOARD OF WATER COMMISSIONERS  
 416 North State Street  
 Jackson, Mississippi 39201

WATER WELL DRILLERS LOG

3/7 1976 Bud Johnson Pearl River  
 date well completed firm name county well located

LANDOWNER: ~~James Whitfield~~  
 Shane

description of formations encountered	from	to
Red shale	0	35
Red clay	35	80
Blue shale	80	200
Grey sand	200	225

the well miss.  
 (mailing address)

WELL LOCATION:  
 sec. 29 T. 4 N R. 16 E  
 3 miles E of the well  
 (distance) (direction) (nearest town)


WELL PURPOSE: home  
 (home, irrigation, municipal, industrial)

WELL COMPLETION DATA:

- (1) diameter (inches) 2 1/2
- (2) total depth (feet) 225
- (3) static water level (feet) 65 below top of ground.
- (4) casing PVC, 2 1/2" (depth)  
 20 if telescope see back.  
 (size)
- (5) screen 28 ft, 2 1/2" (depth to top)  
 12 (size), PVC (material)
- (6) pump (HP) (yield gpm)  
 (type power)
- (7) electric log no (yes or no)
- (organization running log)

(8) how well bottom plugged  
 sand & shales


DRILLERS REMARKS:  
 no pump furnished

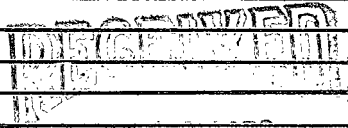

APR 12 1976

If well telescopes please sketch and show depths.

GROUND LEVEL

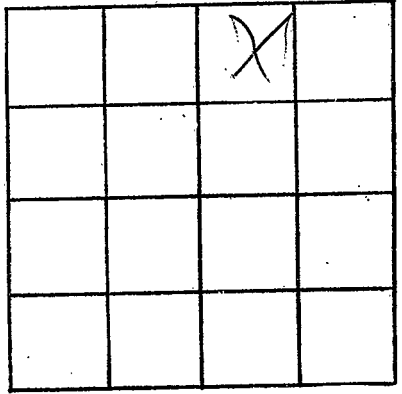

SECTION \_\_\_\_\_

Please indicate well location X.

ADDITIONAL INFORMATION

If more than one screen, show locations of each on sketch.