

**PEARL RIVER**  
 Q 2007  
 3-20-76

MISSISSIPPI  
 BOARD OF WATER COMMISSIONERS  
 416 North State Street  
 Jackson, Mississippi 39201

WATER WELL DRILLERS LOG

3-20 1976 Pantown Well Sewer Pearl River  
 date well completed firm name county well located

LANDOWNER: George Campbell  
McNeill, MS-  
 (mailing address)

description of formations encountered	from	to
Surface Clay	0	25
Blue Clay	25	90
Silt	90	105
Blue Clay	105	240
Sand	240	280

WELL LOCATION:  
 sec. 34 T 4 N R. 16 E  
1 miles East of McNeill  
 (distance) (direction) (nearest town)

WELL PURPOSE: Home  
 (home, irrigation, municipal, industrial)

- WELL COMPLETION DATA:
- (1) diameter (inches) 2
  - (2) total depth (feet) 280
  - (3) static water level (feet) 43 below/above top of ground.
  - (4) casing Galv. 270  
 (material) (depth)  
2 If telescope see back.  
 (size)
  - (5) screen 10 270  
 (length) (depth to top)  
2 St. Steel  
 (size) (material)
  - (6) pump 1 10  
 (HP) (yield gpm)  
Elac  
 (type power)
  - (7) electric log No  
 (yes or no)


(organization running log)  
 (8) how well bottom plugged Bar. Value

DRILLERS REMARKS:

MISSISSIPPI  
 BOARD OF WATER COMMISSIONERS  
 APR 27 1976  
 MISS. BB. OF WATER COMMISSIONERS

If well telescopes please sketch and show depths.

GROUND LEVEL

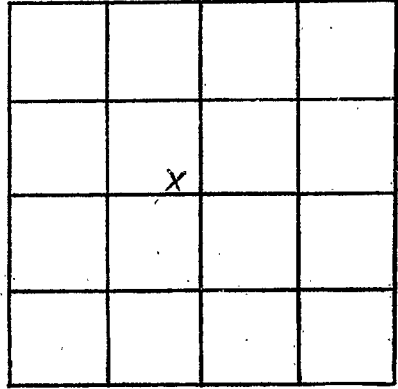

SECTION 34

Please indicate well location X.

ADDITIONAL INFORMATION

If more than one screen,  
show locations of each on sketch.