

Pearl River
Q 2008
9-17-76

MISSISSIPPI
 BOARD OF WATER COMMISSIONERS
 416 North State Street
 Jackson, Mississippi 39201

WATER WELL DRILLERS LOG

9-17 1976 Pondsey water well Pearl River
 date well completed well name county well located

LANDOWNER: LARRY W Smith
RT 4 Box 144
Poglesville, MS. 39466
 (mailing address)

description of formations encountered	from	to
	<u>sl - clay mix</u>	<u>0</u>
<u>white clay</u>	<u>36</u>	<u>40</u>
<u>Blu. clay -</u>	<u>40</u>	<u>64</u>
<u>hd Blu shale</u>	<u>64</u>	<u>94</u>
<u>sd - fair -</u>	<u>94</u>	<u>116</u>

WELL LOCATION:
 sec. 7 T. 4 N. R. 16 E.
2 miles SW of Millers
 (distance) (direction) (nearest town)

WELL PURPOSE: Home
 (home, irrigation, municipal, industrial)

- WELL COMPLETION DATA:
- (1) diameter (inches) 2
 - (2) total depth (feet) 116
 - (3) static water level (feet) 65 below above top of ground.
 - (4) casing PVC 40, 106,
 (material) (depth)
2' If telescope see back.
 (size)
 - (5) screen 10', 106
 (length) (depth to top)
2, PVC slot wrap -
 (size) (material)
 - (6) pump _____
 (HP) (yield gpm)
 (type power)
 - (7) electric log _____
 (yes or no)
 (organization running log)
 - (8) how well bottom plugged Sealed

RECEIVED


OCT 15 1976

DRILLERS REMARKS: fair deep
well sd - water good.

MISS. BD. OF WATER COMM.

If well telescopes please sketch and show depths.

GROUND LEVEL

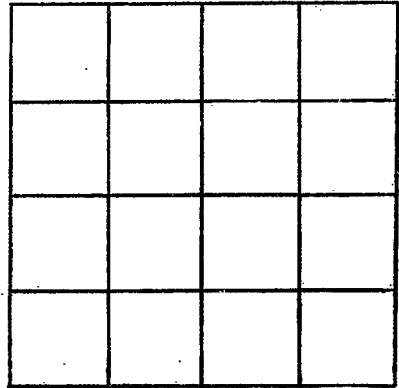

SECTION _____

Please indicate well location X.

ADDITIONAL INFORMATION

If more than one screen, show locations of each on sketch.