

Pearl River
Q 2009
5-4-77

MISSISSIPPI
 BOARD OF WATER COMMISSIONERS
 416 North State Street
 Jackson, Mississippi 39201

WATER WELL DRILLERS LOG

5-4 ^{13V} 1977 Penton Well Serv Pearl River
 date well completed firm name county well located

LANDOWNER: Coel Craft
Mc Neil
MISS-
 (mailing address)

description of formations encountered	from	to
Surface clay	0	6
Blue clay	6	130
Sand	130	150
Blue clay	150	230
Sand	230	360
Blue clay	360	780
Sand	780	800

WELL LOCATION:
 sec. 34 T 4 N R. 16 E
3 miles East of McNeil
 (distance) (direction) (nearest town)

WELL PURPOSE: Home
 (home, irrigation, municipal, industrial)

- WELL COMPLETION DATA:
- (1) diameter (inches) 2
 - (2) total depth (feet) 800
 - (3) static water level (feet) 40 below top of ground.
 - (4) casing Gale, 790
 (material) (depth)
2 if telescope see back.
 (size)
 - (5) screen 10', 790
 (length) (depth to top)
2, S. Steel
 (size) (material)
 - (6) pump 1, 12
 (HP) (yield. gpm)
Elec
 (type power)
 - (7) electric log NO
 (yes or no)
 (organization running log)
 - (8) how well bottom plugged B.W. Valve


RECEIVED
 JUN 10 1977

MISS. BD. OF WATER COMM

DRILLERS REMARKS:

If well telescopes please sketch and show depths.

GROUND LEVEL

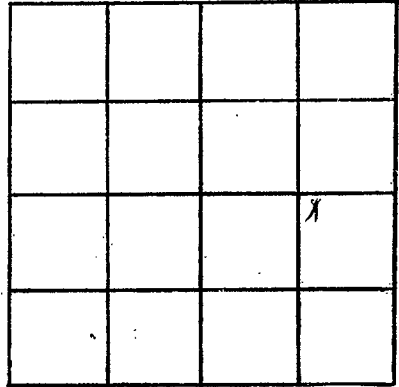

SECTION 34

Please indicate well location X.

ADDITIONAL INFORMATION

A series of horizontal lines for writing additional information.

If more than one screen, show locations of each on sketch.