

Pearl R.
 Q 2010
 6/17/77

MISSISSIPPI
 BOARD OF WATER COMMISSIONERS
 416 North State Street
 Jackson, Mississippi 39201

WATER WELL DRILLERS LOG

6-17 date well completed 1977 Bud Centeno, Jr. firm name Pearl River county well located

LANDOWNER: Dale Sprain
 PO Box 85
 McNeill, Miss.
 (mailing address)

description of formations encountered	from	to
Red Shale	0	42
Red Sand	42	75

WELL LOCATION:
 sec 29 T 4 N R 14 E
 1 1/2 miles E of McNeill
 (distance) (direction) (nearest town)

WELL PURPOSE: Home
 (home, irrigation, municipal, industrial)

WELL COMPLETION DATA:

(1) diameter (inches) 2 in.
 (2) total depth (feet) 73
 (3) static water level (feet) 42 below top of ground.
 (4) casing PVC 67 (material) (depth)
 (size) if telescope see back.
 (5) screen 2x6 67 (length) (depth to top)
 12 PVC (size) (material)
 (6) pump 1 350 (HP) (yield gpm)
 electric 5.599m (type power)
 (7) electric log NO (yes or no)

(organization running log)
 (8) how well bottom plugged
 Sand Shale

DRILLERS REMARKS:


RECEIVED

DEC 8 0 1977

MISS. BD. OF WATER COMMISSIONERS

If well telescopes please sketch and show depths.

GROUND LEVEL

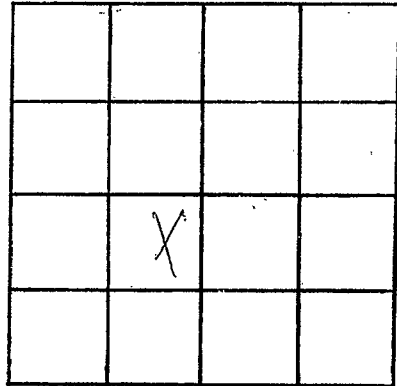

SECTION _____

Please indicate well location X.

ADDITIONAL INFORMATION

A series of horizontal lines for writing additional information, starting below the 'ADDITIONAL INFORMATION' header and extending to the bottom of the page.

If more than one screen, show locations of each on sketch.