

Pearl River
Q 2012
7-6-77

MISSISSIPPI
 BOARD OF WATER COMMISSIONERS
 416 North State Street
 13V Jackson, Mississippi 39201

7-6- 1977 STOCKSTILL BROS., INC. Pearl River
 date well completed firm name county well located

LANDOWNER:
Mr. Ed Mallory
Carriere, Miss.
 (mailing address)

description of formations encountered	from	to
Clay	0	30
Sand	30	125
Clay	125	190
Sand	190	234

WELL LOCATION:
 sec. 29 T-40 N R-16 E
3 miles E of McKee
 (distance) (direction) (nearest town)

WELL PURPOSE: Home
 (home, irrigation, municipal, industrial)


- WELL COMPLETION DATA:
- (1) diameter (inches) 2
 - (2) total depth (feet) 234
 - (3) static water level (feet) 75' below top of ground.
 - (4) casing P.V.C., 229,
 (material) (depth)
2" if telescope see back.
 (size)
 - (5) screen 5', 229
 (length) (depth to top)
2", P.V.C.
 (size) (material)
 - (6) pump 1/2, 25
 (HP) (yield gpm)
Elec.
 (type power)
 - (7) electric log No
 (yes or no)
No
 (organization running log)
 - (8) how well bottom plugged Sand & silt

RECEIVED
 SEP 22 1977
 MISS. BD. OF WATER COMMISSIONERS

DRILLERS REMARKS:

If well telescopes please sketch and show depths.

GROUND LEVEL

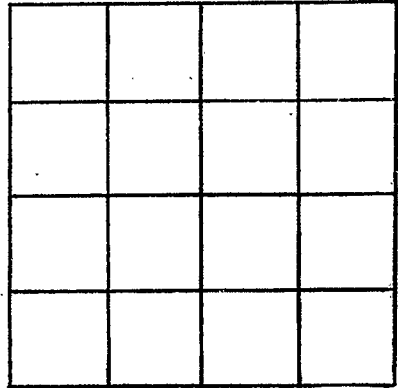

SECTION _____

Please indicate well location X.

ADDITIONAL INFORMATION

If more than one screen,
show locations of each on sketch.