

PEARL, RIVER
 0
 2014

MISSISSIPPI
 BOARD OF WATER COMMISSIONERS
 416 North State Street
 Jackson, Mississippi 39201

WATER WELL DRILLERS LOG

2/16 1978 *Bohannon & Sons Pearl River*
 date well completed firm name county well located

LANDOWNER: *M. J. Miller*
 B.T. 3 Box 41 A
 Poplarville Miss.
 (mailing address)


description of formations encountered	from	to
<i>Red shale</i>	<i>0</i>	<i>67</i>
<i>Red sand</i>	<i>67</i>	<i>115</i>
<i>Red shale</i>	<i>115</i>	<i>203</i>
<i>Red sand</i>	<i>203</i>	<i>265</i>

WELL LOCATION:
 sec. 4 T. 4 N. R. 7E
2 miles South of Bohannon
 (distance) (direction) (nearest town)

WELL PURPOSE: home
 (home, irrigation, municipal, industrial)

- WELL COMPLETION DATA:
- (1) diameter (inches) 4"
 - (2) total depth (feet) 265
 - (3) static water level (feet) 32 below top of ground.
 - (4) casing PVC, 265'
 (material) (depth)
no if telescope see back.
 (size)
 - (5) screen 4x10, 955
 (length) (depth to top)
1/2", PVC
 (size) (material)
 - (6) pump 1, 1650
 (HP) (yield gpm)
elect
 (type power)
 - (7) electric log no
 (yes or no)


(organization running log)
 (8) how well bottom plugged hard
short
 DRILLERS REMARKS:

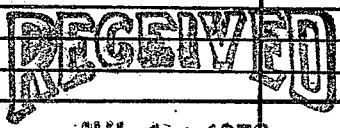

JUL 14 1978

If well telescopes please sketch and show depths.

GROUND LEVEL

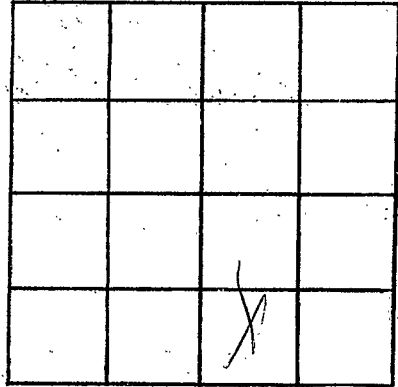

SECTION _____

Please indicate well location X.

ADDITIONAL INFORMATION

A series of horizontal lines for writing additional information, starting below the 'ADDITIONAL INFORMATION' header and extending to the bottom of the page.

If more than one screen, show locations of each on sketch.