

Pearl River
(P) 2006
3-6-79
3-6

MISSISSIPPI
 BOARD OF WATER COMMISSIONERS
 416 North State Street
 Jackson, Mississippi 39201

WATER WELL DRILLERS LOG

date well completed.

firm name

POUNCEY WATER WELL DRILLING

county well located

Pearl River

LANDOWNER: E. D. McNeil
McNeil
RFD
 (mailing address)

Description of formations encountered	from	to
<u>Clay</u>	<u>0</u>	<u>70</u>
<u>sch.</u>	<u>70</u>	<u>78</u>

WELL LOCATION:
 sec 33 T 4 N R 16 E
3 miles E of McNeil
 (distance) (direction) (nearest town)

WELL PURPOSE: drinking
 (home, irrigation, municipal, industrial)

- WELL COMPLETION DATA:
- (1) diameter (inches) 2 1/8
 - (2) total depth (feet) 78
 - (3) static water level (feet) 40 below top of ground
 - (4) casing pre 78
 (material) (depth)
2 if telescope see back.
 (size)
 - (5) screen 5 73
 (length) (depth to top)
2 pre
 (size) (material)
 - (6) pump 1 8
 (HP) (yield gpm)
AC
 (type power)
 - (7) electric log /
 (yes or no)
/
 (organization running log)
 - (8) how well bottom plugged Sealed

DRILLERS REMARKS: /


Miss. Board of Water Comm.

APR 2 - 1979

RECEIVED

If well telescopes please sketch and show depths.

GROUND LEVEL

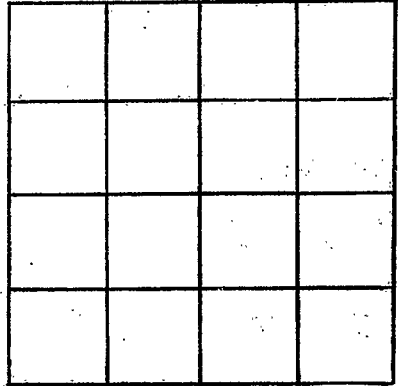

SECTION _____

Please indicate well location X.

ADDITIONAL INFORMATION

If more than one screen, show locations of each on sketch.