

Pearl River
Q 2017
8-30-79

MISSISSIPPI
 BOARD OF WATER COMMISSIONERS
 416 North State Street
 Jackson, Mississippi 39201

Q

WATER WELL DRILLERS LOG

8-30-79 date well completed PENTON Well Serv firm name Pearl River county well located

LANDOWNER: Larry Lee
Rt.
Cumiere MS.
 (mailing address)
 WELL LOCATION:
 sec. 36 T. (4) N. R. (16) W.
5 1/2 miles East of McNeil
 (distance) (direction) (nearest town)

| description of formations encountered | from | to |
|---------------------------------------|------|-----|
| Surface Clay | 0 | 30 |
| Sand | 30 | 50 |
| Blue Clay | 50 | 120 |
| Sand | 120 | 280 |
| Blue Clay | 280 | 500 |
| SILT | 500 | 580 |
| Blue Clay | 580 | 770 |
| Sand | 770 | 816 |

WELL PURPOSE: home
 (home, irrigation, municipal, industrial)


WELL COMPLETION DATA:
 (1) diameter (inches) 2"
 (2) total depth (feet) 816'
 (3) static water level (feet) 50' below above top of ground.
 (4) casing Galv. 806'
 (material) (depth)
2" if telescope see back.
 (size)
 (5) screen 10' 806'
 (length) (depth to top)
2" S. Steel
 (size) (material)
 (6) pump 1 9
 (HP) (yield gpm)
Elec
 (type power)
 (7) electric log NO.
 (yes or no)
 (organization running log)
 (8) how well bottom plugged BW Valve

McC 810-2122
Paul

DRILLERS REMARKS:

If well telescopes please sketch and show depths.

GROUND LEVEL

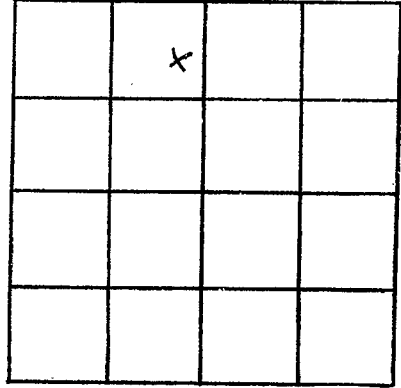

SECTION 36

Please indicate well location X.

ADDITIONAL INFORMATION

If more than one screen, show locations of each on sketch.