

Pearl Ri.  
Q 2018  
10-30-79

MISSISSIPPI  
 BOARD OF WATER COMMISSIONERS  
 416 North State Street  
 Jackson, Mississippi 39201

WATER WELL DRILLERS LOG

10/30 1979 Budgerston Pearl River  
 date well completed firm name county well located

LANDOWNER: Anthony Digiovanni  
RT 2 Worned Miss.  
 (mailing address)

description of formations encountered	from	to
<u>Red shale</u>	<u>0</u>	<u>60</u>
<u>Red sand</u>	<u>60</u>	<u>96</u>
<u>Blue shaly</u>	<u>96</u>	<u>265</u>
<u>dry sand</u>	<u>265</u>	<u>275</u>

WELL LOCATION:  
 sec. 10 T 4 N R 16 E  
2 miles East of Worned  
 (distance) (direction) (nearest town)

WELL PURPOSE: home  
 (home, irrigation, municipal, industrial)

- WELL COMPLETION DATA:
- (1) diameter (inches) 2
  - (2) total depth (feet) 275
  - (3) static water level (feet) 60 below top of ground.
  - (4) casing pvc 265  
 (material) (depth)  
 (size) If telescope see back.
  - (5) screen 10ft 265  
 (length) (depth to top)  
1/2 pvc  
 (size) (material)
  - (6) pump 1 450 gph  
 (HP) (yield gpm)
  - Elect  
 (type power)
  - (7) electric log no  
 (yes or no)

(8) how well bottom plugged  
sand shork

DRILLERS REMARKS:


DEPT. OF NATURAL RESOURCES  
 BUREAU OF LAND & WATER RESOURCES

JAN 7 1980

RECEIVED

If well telescopes please sketch and show depths.

GROUND LEVEL

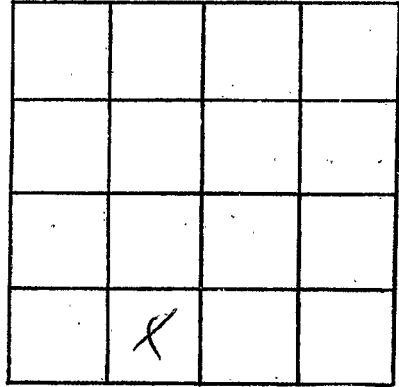

SECTION \_\_\_\_\_

Please indicate well location X.

ADDITIONAL INFORMATION

If more than one screen,  
show locations of each on sketch.