

Pearl River
Q 2019
9-11-81

MISSISSIPPI DEPARTMENT OF NATURAL RESOURCES
 Bureau of Land and Water Resources
 Southport Mall
 P.O. Box 10631
 Jackson, Mississippi 39209
WATER WELL DRILLERS LOG

4

Sept 11 - 1981 Ed Walker Welding & Repair Pearl River
 date well completed firm names county well located
Billy C Walker

LANDOWNER: <u>A.C. Touchy M.D.</u>	description of formations encountered	from	to
<u>M S Neil, Miss</u>	<u>Red shale</u>	<u>0</u>	<u>15'</u>
(mailing address)	<u>Red gravel</u>	<u>15</u>	<u>17'</u>
WELL LOCATION:	<u>Blue shale</u>	<u>17</u>	<u>25'</u>
sec. <u>30</u> T. <u>4</u> S. R. <u>16</u> W.	<u>White sand zone</u>	<u>25</u>	<u>85'</u>
<u>2</u> miles <u>NE</u> of <u>M S Neil</u>	<u>Blue shale</u>	<u>85</u>	<u>234'</u>
(distance) (direction) (nearest town)	<u>Blue sand</u>	<u>234</u>	<u>270'</u>
WELL PURPOSE: <u>pond</u> (home, irrigation, municipal, industrial)			
WELL COMPLETION DATA:			
(1) diameter (inches) <u>3" x 2"</u>			
(2) total depth (feet) <u>270'</u>			
(3) static water level (feet) <u>100'</u> below top of ground.			
(4) casing <u>PVC</u> , <u>270'</u> (material) (depth)			
<u>Yes</u> If telescope see back. (size)			
(5) screen <u>2" x 10'</u> , <u>260'</u> (length) (depth to top)			
<u>12</u> , <u>PVC</u> (size) (material)			
(6) pump <u>no</u> <u>Windmill</u> (HP) (yield gpm)			
<u>Windmill</u> (type power)			
(7) electric log <u>no</u> (yes or no)			
_____ (organization running log)			
(8) how well bottom plugged <u>Sand shank</u>			
DRILLERS REMARKS:			


MISSISSIPPI DEPARTMENT OF NATURAL RESOURCES
 BUREAU OF LAND & WATER RESOURCES

OCT - 6 1981

RECEIVED

If well telescopes please sketch and show depths.

GROUND LEVEL

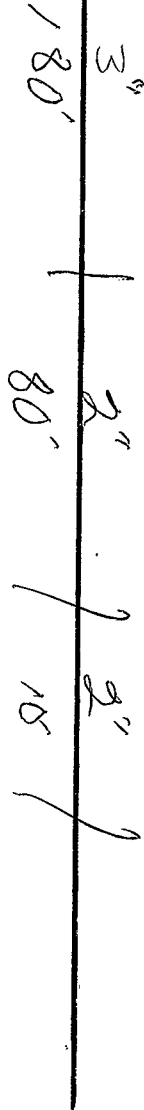

X			

SECTION _____

Please indicate well location X.

ADDITIONAL INFORMATION

If more than one screen, show locations of each on sketch.