

MISSISSIPPI DEPARTMENT OF NATURAL RESOURCES

Bureau of Land and Water Resources

Southport Mall

P.O. Box 10631

Jackson, Mississippi 39209

WATER WELL DRILLERS LOG

Pearl River
Q 2020
7-31-81

BOUNCEY WATER WELL DRILLING

Pearl River

date well completed 19 81

firm name

county well located

LANDOWNER: Sidney Martin

Description of formations encountered

from

to

McNeil

Top

0 12

(mailing address)

Boge Clay

12 60

WELL LOCATION:

sec. 3 T. 4 N. R. 16 E.
12 miles (distance) N (direction) of Picayune (nearest town)

Blue

60 140

Steel

140 190

WELL PURPOSE:

(home irrigation, municipal, industrial) Home

WELL COMPLETION DATA:

- (1) diameter (inches) 2
- (2) total depth (feet) 190
- (3) static water level (feet) 18 below top of ground
- (4) casing PVC 194 (material) (depth)
2 (size) if telescope see back.
- (5) screen 6 194 (length) (depth to top)
2 PVC (size) (material)
- (6) pump 1 12 (HP) (yield gpm)
AC 220V (type power)
- (7) electric log / (yes or no)
 (organization running log)
- (8) how well bottom plugged Sealed

DEPT. OF NATURAL RESOURCES
 BUREAU OF LAND & WATER RESOURCES

SEP 18 1981

RECEIVED


RECEIVED
 SEP 18 1981
 1981
 1 2 3 4 5 6 7 8 9 10 11 12 13 14 15 16 17 18 19 20 21 22 23 24 25 26 27 28 29 30 31

DRILLERS REMARKS:

Sand
Screen to 6 ft. because
only good sd. was bottom

If well telescopes please sketch and show depths.

GROUND LEVEL

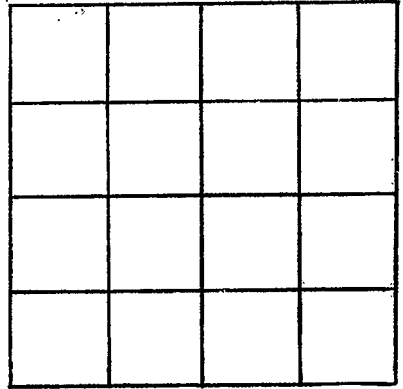

SECTION _____

Please indicate well location X.

ADDITIONAL INFORMATION

If more than one screen,
show locations of each on sketch.