

MISSISSIPPI DEPARTMENT OF NATURAL RESOURCES

Bureau of Land and Water Resources

Southport Mall

P.O. Box 10631

Jackson, Mississippi 39209

WATER WELL DRILLERS LOG

Pearl River  
Q 2021  
9-7-81

9-7-81  
date well completed

BUD PENTON & SON  
WATER WELL SERVICE  
ROUTE 41  
MORNING STAR, MS 39026  
PHONE 798-5324

Pearl River  
county well located

LANDOWNER: Howard Bunge  
Bunge - McNeil MS.

description of formations encountered	from	to
Grey shale	0	35
Blue shale	35	90
Blue sand	90	120
Blue shale	120	275
Blue sand	275	332

(mailing address)

WELL LOCATION:  
sec 39 T 4 N R 16 E  
4 miles E of McNeil  
(distance) (direction) (nearest town)

WELL PURPOSE: Home  
(home, irrigation, municipal, industrial)

- WELL COMPLETION DATA:
- (1) diameter (inches) 2
  - (2) total depth (feet) 332
  - (3) static water level (feet) 40 below top of ground.
  - (4) casing PVC 322 (material) (depth)
  - (5) screen 10 322 (length) (depth to top)
  - (6) pump 2 PVC (size) (material)
  - (7) pump 1 800 (HP) (yield gpm)
  - (8) electric log (yes or no)

(organization running log)

(8) how well bottom plugged

DRILLERS REMARKS:


DEPT. OF NATURAL RESOURCES  
BUREAU OF LAND & WATER RESOURCES

NOV 9 1981

RECEIVED

If well telescopes please sketch and show depths.

GROUND LEVEL

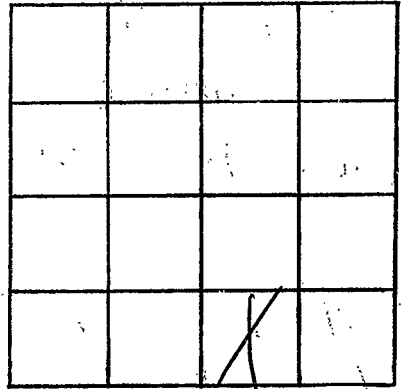

SECTION \_\_\_\_\_

Please indicate well location X.

ADDITIONAL INFORMATION

If more than one screen,  
show locations of each on sketch.