

MISSISSIPPI DEPARTMENT OF NATURAL RESOURCES

Bureau of Land and Water Resources

Southport Mall

P.O. Box 10631

Jackson, Mississippi 39209

WATER WELL DRILLERS LOG

Paul River  
Q  
2000

Aug 19 1982 Walker Wellboring Paul River  
 date well completed firm name county well located

LANDOWNER: Horace Lee  
PO Box 86  
McNeil Miss  
 (mailing address)

description of formations encountered	from	to
<u>Red sand shale</u>	<u>0</u>	<u>20</u>
<u>Reddish Blue shale</u>	<u>20</u>	<u>128</u>
<u>fine sand</u>	<u>128</u>	<u>134</u>
<u>Blue shale</u>	<u>134</u>	<u>232</u>
<u>Black pipe sand</u>	<u>232</u>	<u>272</u>

WELL LOCATION:  
 sec 34 T 4 N R 16 W  
5 miles East of McNeil  
 (distance) (direction) (nearest town)

WELL PURPOSE: Home  
 (home, irrigation, municipal, industrial)

WELL COMPLETION DATA:

(1) diameter (inches) 2"

(2) total depth (feet) 272'

(3) static water level (feet) 68 below top of ground.

(4) casing PVC 262'  
 (material) (depth)

(size) if telescope see back.

(5) screen 10' 262'  
 (length) (depth to top)

12 PVC  
 (size) (material)

(6) pump 1 7  
 (HP) (yield gpm)

Elec  
 (type power)

(7) electric log                       
 (organization running log)

(8) how well bottom plugged Sand  
shank

DRILLERS REMARKS:                     


DEPT. OF NATURAL RESOURCES  
 BUREAU OF LAND & WATER RESOURCES

AUG 23 1982

RECEIVED

If well telescopes please  
sketch and show depths.

GROUND LEVEL

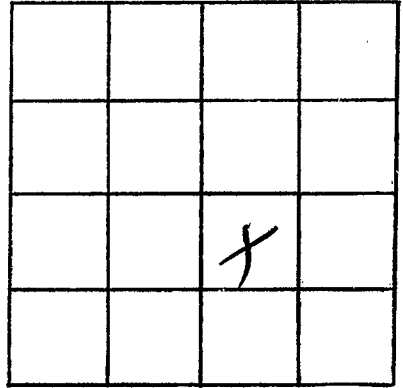

SECTION \_\_\_\_\_

Please indicate well location X.

ADDITIONAL INFORMATION

If more than one screen,  
show locations of each on sketch.