

MISSISSIPPI DEPARTMENT OF NATURAL RESOURCES

Bureau of Land and Water Resources

Southport Mall

P.O. Box 10631

Jackson, Mississippi 39209

WATER WELL DRILLERS LOG

Paul Basse
Q
2023

10-20-82 date well completed
 POUNCEY WATER WELL DRILLING firm name
 Pearl River county well located

LANDOWNER:	Description of formations encountered	from	to
<u>Fred Basse</u> <u>Rt. Picayune</u>	<u>Top -</u>	<u>0</u>	<u>18</u>
(mailing address)	<u>sd -</u>		
WELL LOCATION: sec. <u>36</u> T. <u>4</u> N R. <u>16</u> E <u>5</u> miles <u>N</u> of <u>CAESAR</u> (distance) (direction) (nearest town)	<u>Clay -</u>	<u>18</u>	<u>38</u>
	<u>sd.</u>	<u>123</u>	<u>300</u>
WELL PURPOSE: (home, irrigation, municipal, industrial)	<u>HD HD clay sand</u>	<u>300</u>	<u>748</u>
WELL COMPLETION DATA:	<u>Rock -</u>		
(1) diameter (inches) <u>2</u>	<u>Set,</u>	<u>748</u>	<u>764</u>
(2) total depth (feet) <u>270</u>	<u>Shale gully</u>	<u>764</u>	<u>840</u>
(3) static water level (feet) <u>35</u> below top of ground			
(4) casing <u>PVC 260</u> (material) (depth)			
(size) if telescope see back.			
(5) screen <u>10 260</u> (length) (depth to top)			
(size) (material)			
(6) pump <u>1 10</u> (HP) (yield gpm)			
(type power)			
(7) electric log <u>NO</u> (yes or no)			
(organization running log)			
(8) how well bottom plugged <u>Sealed.</u>			


RECEIVED
 DEC 23 1982

DEPT. OF NATURAL RESOURCES
 BUREAU OF LAND & WATER RESOURCES

DRILLERS REMARKS: Good
Producing well - also
drilled to 840 - dry -
see log.

If well telescopes please sketch and show depths.

GROUND LEVEL

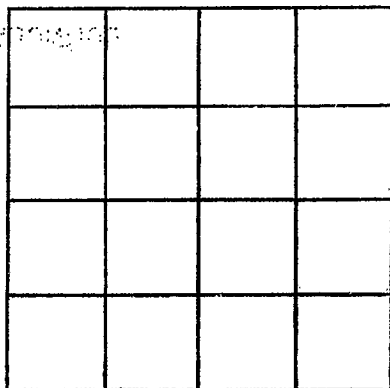

SECTION _____

Please indicate well location X.

ADDITIONAL INFORMATION

If more than one screen, show locations of each on sketch.