

MISSISSIPPI DEPARTMENT OF NATURAL RESOURCES

Bureau of Land and Water Resources

Southport Mall

P.O. Box 10631

Jackson, Mississippi 39209

BUD PENTON & SON
WATER WELL SERVICE
ROUTE 4 BOX 402
CARRIERE, MS 39426
PHONE 798-5324

BUD PENTON & SON
WATER WELL DRILLERS LOG

ROUTE BOX
CARRIERE, MS 39426
PHONE 798-5324

Pearl River
Q 2024

4/11 1983
date/well completed

Pearl River
county well located

LANDOWNER: Mr. Nugent
R.J. Millard Road

description of formations encountered	from	to
<u>Red Shale</u>	<u>0</u>	<u>30</u>
<u>Blue shale</u>	<u>30</u>	<u>80</u>
<u>Gray Sand</u>	<u>80</u>	<u>107</u>

(mailing address)

WELL LOCATION:
sec. 11 T. 4 N. R. 16 E.
S. W.
5 miles N of McNeil
(distance) (direction) (nearest town)

WELL PURPOSE: home
(home, irrigation, municipal, industrial)

- WELL COMPLETION DATA:
- (1) diameter (inches) 2"
 - (2) total depth (feet) 107
 - (3) static water level (feet) 40 below above top of ground.
 - (4) casing PVC, 107,
(material) (depth)
 - (size) if telescope see back.
 - (5) screen 2x5", 102
(length) (depth to top)
 - 10, PVC
(size) (material)
 - (6) pump 1/2, 42
(HP) (yield gpm)
 - elect
(type power)
 - (7) electric log no
(yes or no)

(organization running log)

(8) how well bottom plugged Sand
Shark

DRILLERS REMARKS:


DEPT. OF NATURAL RESOURCES
BUREAU OF LAND & WATER RESOURCES

APR 27 1983

RECEIVED

If well telescopes please sketch and show depths.

GROUND LEVEL

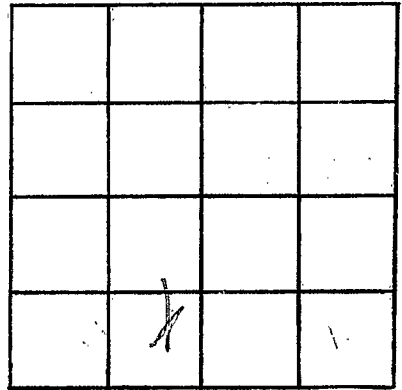

SECTION _____

Please indicate well location X.

ADDITIONAL INFORMATION

If more than one screen,
show locations of each on sketch.