

MISSISSIPPI DEPARTMENT OF NATURAL RESOURCES
Bureau of Land and Water Resources
 Southport Mall
 P.O. Box 10631
 Jackson, Mississippi 39209
WATER WELL DRILLERS LOG

Q 2025
Pearl River

3-28 19 85 WALKERS WELDING & REPAIR PR.
 date well completed firm name county well located

LANDOWNER: LEE HAITZON
PO BOX 74031
METAIRIE LA, 70033
 (mailing address)
 WELL LOCATION:
 sec. 31 T 3 N R. 15 W
4 miles N.E. MEACIL
 (distance) (direction) (nearest town)

description of formations encountered	from	to
<u>CLAY</u>	<u>0</u>	<u>15</u>
<u>SAND</u>	<u>15</u>	<u>25</u>
<u>CLAY</u>	<u>25</u>	<u>78</u>
<u>SAND</u>	<u>78</u>	<u>128</u>

WELL PURPOSE: HOME
 (home, irrigation, municipal, industrial)

WELL COMPLETION DATA:

(1) diameter (inches) 2"

(2) total depth (feet) 128

(3) static water level (feet) 51 below above top of ground.

(4) casing Pvc, 118,
 (material) (depth)
 if telescope see back.
 (size)

(5) screen 10', 118
 (length) (depth to top)
2, PVC
 (size) (material)

(6) pump 1, 12
 (HP) (yield gpm)
ELECTRIC
 (type power)

(7) electric log _____
 (yes or no)

 (organization running log)

(8) how well bottom plugged SAND SHAR


DRILLERS REMARKS: _____

RECEIVED
APR 17 1985

Department of Natural Resources
 Bureau of Land & Water Resources

If well telescopes please sketch and show depths.

GROUND LEVEL

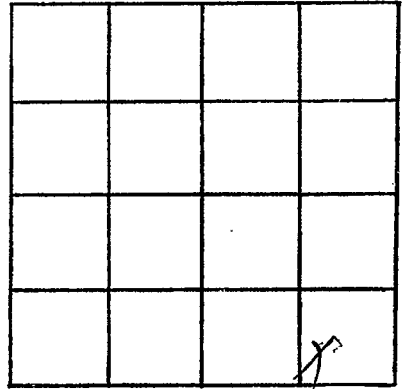

SECTION _____

Please indicate well location X.

ADDITIONAL INFORMATION

If more than one screen,
show locations of each on sketch.