

Q 2006
 Paul Lewis

MISSISSIPPI DEPARTMENT OF NATURAL RESOURCES
 Bureau of Land and Water Resources
 Southport Mall
 P.O. Box 10631
 Jackson, Mississippi 39209
WATER WELL DRILLERS LOG

4-2-1985 WALKERS WELDING & REPAIR PR
 date well completed firm name county well located

LANDOWNER: OLEN LEE
RT. 2
CARRIERS, MS.
 (mailing address)
 WELL LOCATION:
 sec. 10 T. 8 N. R. 16 W.
4 S. W
4 miles E of MENEIL
 (distance) (direction) (nearest town)

description of formations encountered	from	to
CLAY	0	12
SAND	12	38
CLAY	38	146
SAND	146	198

WELL PURPOSE: HOME
 (home, irrigation, municipal, industrial)

- WELL COMPLETION DATA:
- diameter (inches) 2
 - total depth (feet) 198
 - static water level (feet) 18 below ~~above~~ top of ground.
 - casing PVC, 188
 (material) (depth)
 _____ if telescope see back.
 (size)
 - screen 10, 188
 (length) (depth to top)
12, PVC
 (size) (material)
 - pump 1, 74
 (HP) (yield gpm)
ELECTRIC
 (type power)
 - electric log _____
 (yes or no)

 (organization running log)
 - how well bottom plugged SANDSHARK


DRILLERS REMARKS:

RECEIVED
 APR 17 1985

Department of Natural Resources
 Bureau of Land & Water Resources

If well telescopes please sketch and show depths.

GROUND LEVEL

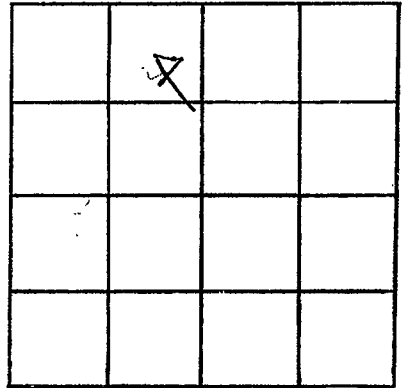

SECTION _____

Please indicate well location X.

ADDITIONAL INFORMATION

If more than one screen,
show locations of each on sketch.