

MISSISSIPPI DEPARTMENT OF NATURAL RESOURCES

Bureau of Land and Water Resources

Southport Mall

P.O. Box 10631

Jackson, Mississippi 39209

WATER WELL DRILLERS LOG

Pearl River
Q2007

9/27
date well completed

1985-Bedport Water Research
firm name

Pearl
county well located

LANDOWNER: F SFC ON

RT-2 Box 449
Carver Miss
(mailing address)

WELL LOCATION:

sec 36 T 4 N R 16 E
S W
12 miles E of Carver
(distance) (direction) (nearest town)

WELL PURPOSE: home
(home, irrigation, municipal, industrial)

WELL COMPLETION DATA:

- (1) diameter (inches) 4"
- (2) total depth (feet) 491
- (3) static water level (feet) 100 below above top of ground.
- (4) casing PVC, 491, (material), (depth)
4" if telescope see back. (size)
- (5) screen 4x20, 471 (length), (depth to top)
12, PVC (size), (material)
- (6) pump 2 (HP), 1350 (yield gpm)
Elet (type power)
- (7) electric log no (yes or no)

(organization running log)

(8) how well bottom plugged sand
Shack

DRILLERS REMARKS:

description of formations encountered

from to

Red shale	0	40
Red sand	40	60
Blue shale	60	220
Gray sand	220	305
Blue shale	305	440
Gray sand	440	491


RECEIVED

FEB 12 1986

Department of Natural Resources
Bureau of Land & Water Resources

If well telescopes please sketch and show depths.

GROUND LEVEL

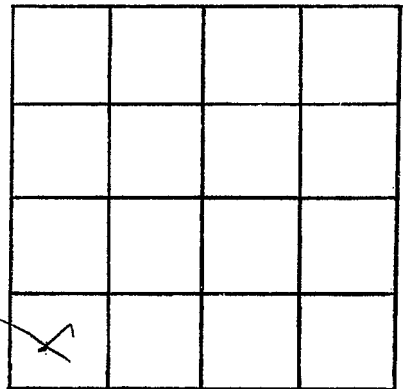

SECTION _____

Please indicate well location X.

ADDITIONAL INFORMATION

If more than one screen,
show locations of each on sketch.