

**MISSISSIPPI DEPARTMENT OF NATURAL RESOURCES**  
 Bureau of Land and Water Resources  
 Southport Mall  
 P.O. Box 10631  
 Jackson, Mississippi 39209  
**WATER WELL DRILLERS LOG**

PEARL RIVER  
9  
2028

May 27 19 86 Walkers welding Pearl River  
 date well completed firm name county well located

LANDOWNER: Elijah Lee

description of formations encountered

from to

RT2 Box 511c

Carrlere Miss  
 (mailing address)

**WELL LOCATION:**


sec. 34 T 14 N R 16 E  
 S W  
5 miles East of Moneil  
 (distance) (direction) (nearest town)

WELL PURPOSE: Home  
 (home, irrigation, municipal, industrial)

**WELL COMPLETION DATA:**

- (1) diameter (inches) 2<sup>1/2</sup>
- (2) total depth (feet) 290<sup>1/2</sup>
- (3) static water level (feet) 60<sup>1/2</sup> below top of ground.
- (4) casing PVC 280<sup>1/2</sup>  
 (material) (depth)  
         if telescope see back.  
 (size)
- (5) screen 101 280<sup>1/2</sup>  
 (length) (depth to top)  
4/10 PVC  
 (size) (material)
- (6) pump T 8gpm  
 (HP) (yield gpm)  
F  
 (type power)
- (7) electric log           
 (yes or no)  
          
 (organization running log)
- (8) how well bottom plugged SANDS SHARK

White clay	0	25
Red sand	25	30
Blue Clay	30	210
Fine sand	210	250
Coarse Sand	250	290

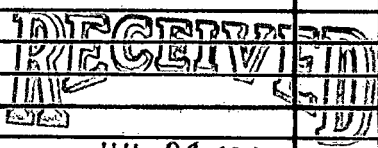

Department of Natural Resources  
 Bureau of Land & Water Resources

DRILLERS REMARKS:  
Good Well

If well telescopes please sketch and show depths.

GROUND LEVEL

			X

SECTION \_\_\_\_\_

Please indicate well location X.

ADDITIONAL INFORMATION

If more than one screen,  
show locations of each on sketch.