

MISSISSIPPI DEPARTMENT OF NATURAL RESOURCES

Bureau of Land and Water Resources

Southport Mall

P.O. Box 10631

Jackson, Mississippi 39209

WATER WELL DRILLERS LOG

Pearl River
Q 2030

2/17 1987 Red Penton Pearl River
 date well completed firm name county well located

LANDOWNER: Dennis Williams
PO Box 144 - MC Neal
Ms 39437
 (mailing address)

WELL LOCATION:
 sec. 9 T. 4 N R. 16 E
 S W
4 miles North of Mc Neal
 (distance) (direction) (nearest town)

WELL PURPOSE: home
 (home, irrigation, municipal, industrial)

WELL COMPLETION DATA:

- (1) diameter (inches) 4
- (2) total depth (feet) 650
- (3) static water level (feet) 135 below top of ground.
- (4) casing PVC, 650,
 (material) (depth)
4 1/2 If telescope see back.
 (size)
- (5) screen 15 (length) (depth to top)
12, PVC
 (size) (material)
- (6) pump 1 1/2 1100
 (HP) (yield gpm)
Elect
 (type power)
- (7) electric log no
 (yes or no)
 (organization running log)
- (8) how well bottom plugged hard
short

Description of formations encountered	from	to
<u>Red Shale</u>	<u>0</u>	<u>60</u>
<u>Red sand & rocks</u>	<u>60</u>	<u>120</u>
<u>Blue Shale</u>	<u>120</u>	<u>200</u>
<u>Blue sand</u>	<u>200</u>	<u>289</u>
<u>Blue shale</u>	<u>289</u>	<u>600</u>
<u>Gray sand</u>	<u>600</u>	<u>650</u>

RECEIVED

JUN 12 1987

Department of Natural Resources
 Bureau of Land and Water Resources


DRILLERS REMARKS:

If well telescopes please sketch and show depths.

GROUND LEVEL

900ft 4"

450ft 2"

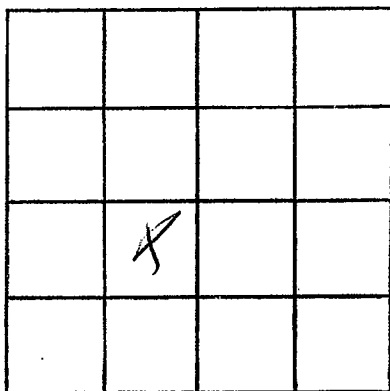

SECTION _____

Please indicate well location X.

ADDITIONAL INFORMATION

If more than one screen, show locations of each on sketch.