

MISSISSIPPI DEPARTMENT OF NATURAL RESOURCES

Bureau of Land and Water Resources

Southport Mall

P.O. Box 10631

Jackson, Mississippi 39209

WATER WELL DRILLERS LOG

P. RIVER  
Q 2032

7/23 date well completed

1988 Bud Benton firm name

Pearl River county well located

LANDOWNER: elvian Felgromis, Sr. 11 McNeil mess.  
(mailing address)


description of formations encountered	from	to
Red shell	0	35
Bedland	35	76
Blue shale	76	230
Blue sand	230	280
Blue shale	280	600
Gravel	600	662

WELL LOCATION:  
sec 20 T H N R 16 E  
S W  
1 miles North of McNeil  
(distance) (direction) (nearest town)

WELL PURPOSE: None  
(home, irrigation, municipal, industrial)

WELL COMPLETION DATA:

- (1) diameter (inches) 8"
- (2) total depth (feet) 662
- (3) static water level (feet) 35 below top of ground.
- (4) casing PVC (material), 662 (depth)  
(size) if telescope see back.
- (5) screen 10 (length), 65 (depth to top)  
12 (size), PVC (material)
- (6) pump no (HP), (yield gpm)  
(type power)
- (7) electric log no (yes or no)  
(organization running log)
- (8) how well bottom plugged Sand  
Shale

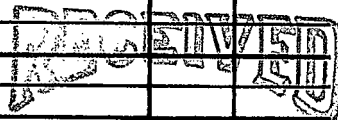

NOV 15 1988

Department of Natural Resources  
Bureau of Land and Water Resources

DRILLERS REMARKS: no pump furnished

