

MISSISSIPPI DEPARTMENT OF NATURAL RESOURCES
Bureau of Land and Water Resources
 Southport Mall
 P.O. Box 10631
 Jackson, Mississippi 39209
WATER WELL DRILLERS LOG

P. RIVER
 Q 2034

2-17 1989 Bud Penton Pearl River
 date well completed firm name county well located
 Water Well

LANDOWNER: William Long
 R.T. Box
 Poplarwill Mass.
 (mailing address)

Description of formations encountered	from	to
	white shale	0
white sand	70	105
blue shale	105	120
gray sand	120	205

WELL LOCATION:
 sec. 3 T 4 N R 16 E
 S W
 4 miles north of McNeil
 (distance) (direction) (nearest town)

WELL PURPOSE: ~~blueberry~~
 (home, irrigation, municipal, industrial)

- WELL COMPLETION DATA:
- diameter (inches) 4"
 - total depth (feet) 205
 - static water level (feet) 7.5 below top of ground.
 - casing PVC, 205 (material) (depth)
 (size) if telescope see back.
 - screen 20x4" #85 (length) (depth to top)
 1/2" PVC (size) (material)
 - pump 5 (HP) 90 (yield gpm)
 (type power)
 - electric log no (yes or no)
 (organization running log)
 - how well bottom plugged sand sharp

RECEIVED


MAY 24 1989

Department of Natural Resources
 Bureau of Land & Water Resources

DRILLERS REMARKS:

If well telescopes please sketch and show depths.

GROUND LEVEL

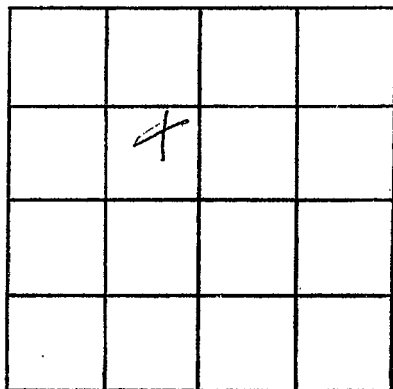

SECTION _____

Please indicate well location X.

ADDITIONAL INFORMATION

If more than one screen,
show locations of each on sketch.