

P. River
Q 2035

MISSISSIPPI DEPARTMENT OF NATURAL RESOURCES
 Bureau of Land and Water Resources
 Southport Mall
 P.O. Box 10631
 Jackson, Mississippi 39209
WATER WELL DRILLERS LOG

8/13 1990 Bud Penton J Pearl River
 date well completed firm name county well located

LANDOWNER: Chesler Lathen description of formations encountered from to
PO Box 49 Carriere Red Shale 20
Miss. Red Sand 20 55
 (mailing address)

WELL LOCATION:
 sec. 33 T 4 N R 16 E
 S W
6 miles E of Maple
 (distance) (direction) (nearest town)

WELL PURPOSE: Home
 (home, irrigation, municipal, industrial)

WELL COMPLETION DATA:

- (1) diameter (inches) 2"
- (2) total depth (feet) 55
- (3) static water level (feet) 25 below above top of ground.
- (4) casing Gal. 5.5
 (material) (depth)
 (size) if telescope see back.
- (5) screen 5 50
 (length) (depth to top)
1.2 PVC
 (size) (material)
- (6) pump 1/2 1400
 (HP) (yield gpm)
Elect
 (type power)
- (7) electric log no
 (yes or no)

(organization running log)

(8) how well bottom plugged Sand
Shark


DRILLERS REMARKS:

RECEIVED
 OCT 15 1990

Department of Natural Resources
 Bureau of Land & Water Resources

If well telescopes please sketch and show depths.

GROUND LEVEL

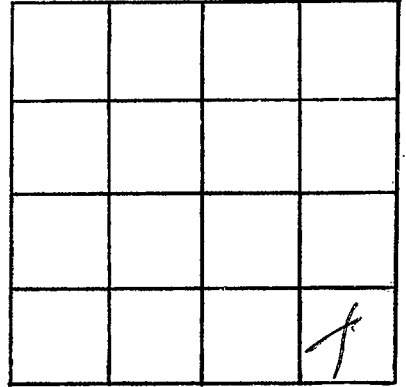

SECTION _____

Please indicate well location X.

ADDITIONAL INFORMATION

If more than one screen,
show locations of each on sketch.