

MISSISSIPPI DEPARTMENT OF NATURAL RESOURCES

Bureau of Land and Water Resources

Southport Mall

P.O. Box 10631

Jackson, Mississippi 39209

WATER WELL DRILLERS LOG

P. RIVER  
CP00030

9/19

date well completed

19

90 Robert Pipes

firm name

Pearl River

county well located

LANDOWNER:

Robert Pipes

description of formations encountered

from

to

PO. Box McNeil  
Miss.

Red Spall  
Red Sand

0 20  
20 45

(mailing address)

WELL LOCATION:

sec. 29 T. 4 N. R. 16 E.

1 miles South of McNeil  
(distance) (direction) (nearest town)

WELL PURPOSE:

(home, irrigation, municipal, industrial)

home

WELL COMPLETION DATA:

- (1) diameter (inches) 2
- (2) total depth (feet) 45
- (3) static water level (feet) 20 below/above top of ground.
- (4) casing pvc 45 (material) (depth)

(size) if telescope see back.

- (5) screen 5 40 (length) (depth to top)
- 12 pvc (size) (material)


- (6) pump no (HP) (yield gpm)

(type power)

- (7) electric log no (yes or no)

(organization running log)

- (8) how well bottom plugged sand  
chuck

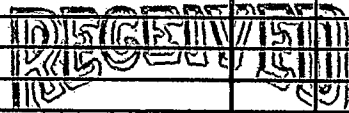


FEB 19 1991

Dept of Environmental Quality  
Bureau of Land & Water Resources

DRILLERS REMARKS:

If well telescopes please sketch and show depths.

GROUND LEVEL

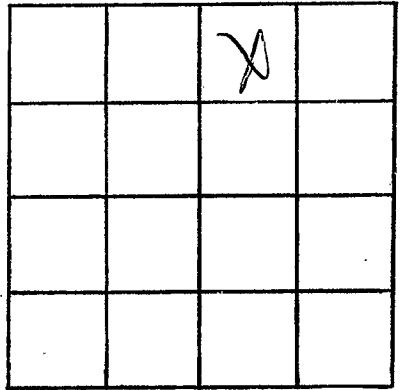

SECTION \_\_\_\_\_

Please indicate well location X.

ADDITIONAL INFORMATION

Lined area for additional information.

If more than one screen, show locations of each on sketch.